
**DICKINSON DAM
EDWARD ARTHUR PATTERSON LAKE
1991 SEDIMENTATION SURVEY**



U.S. Department of the Interior
Bureau of Reclamation

REPORT DOCUMENTATION PAGE			Form Approved OMB No. 0704-0188	
Public reporting burden for this collection of information is estimated to average 1 hour per response, including the time for reviewing instructions, searching existing data sources, gathering and maintaining the data needed, and completing and reviewing the collection of information. Send comments regarding this burden estimate or any other aspect of this collection of information, including suggestions for reducing this burden to Washington Headquarters Services, Directorate for Information Operations and Reports, 1215 Jefferson Davis Highway, Suite 1204, Arlington VA 22202-4302, and to the Office of Management and Budget, Paperwork Reduction Project (0704-0188), Washington DC 20503.				
1. AGENCY USE ONLY (Leave Blank)		2. REPORT DATE September 1995		3. REPORT TYPE AND DATES COVERED Final
4. TITLE AND SUBTITLE Dickinson Dam/Edward Arthur Patterson Lake 1991 Sedimentation Survey				5. FUNDING NUMBERS PR
6. AUTHOR(S) Lori H. Lest				
7. PERFORMING ORGANIZATION NAME(S) AND ADDRESS(ES) Bureau of Reclamation Technical Service Center Denver CO 80225				8. PERFORMING ORGANIZATION REPORT NUMBER
9. SPONSORING/MONITORING AGENCY NAME(S) AND ADDRESS(ES) Bureau of Reclamation Denver Federal Center PO Box 25007 Denver CO 80225-0007				10. SPONSORING/MONITORING AGENCY REPORT NUMBER DIBR
11. SUPPLEMENTARY NOTES Microfiche and hard copy available at the Technical Service Center, Denver, Colorado				
12a. DISTRIBUTION/AVAILABILITY STATEMENT Available from the National Technical Information Service, Operations Division, 5285 Port Royal Road, Springfield, Virginia 22161				12b. DISTRIBUTION CODE
13. ABSTRACT (Maximum 200 words) The Natural Resources Conservation Service surveyed Edward Arthur Patterson Lake in 1991. The field data were used for computing the storage-elevation relationship. The report describes the survey procedures used during the 1991 collection and provides data for future surveys. As of 1991, at reservoir spillway crest elevation 2,420.0 (feet), the surface area was 1,194 acres with a total storage capacity of 8,612 acre-feet. Since the reservoir's initial filling in May 1950, 1,885 acre-feet of sediment have been trapped in Edward Arthur Patterson Lake. The average annual sediment accumulation rate is 46 acre-feet per year for the 41-year period of operation.				
14. SUBJECT TERMS -- reservoir area and capacity/ sedimentation/ reservoir surveys/ sonar/ sediment distribution/ contour area/ reservoir area/ sedimentation survey/				15. NUMBER OF PAGES 55
				16. PRICE CODE
17. SECURITY CLASSIFICATION OF REPORT UL	18. SECURITY CLASSIFICATION OF THIS PAGE UL	19. SECURITY CLASSIFICATION OF ABSTRACT UL	20. LIMITATION OF ABSTRACT UL	

**DICKINSON DAM
EDWARD ARTHUR PATTERSON LAKE**

1991 SEDIMENTATION SURVEY

by

Lori H. Lest

Sedimentation and River Hydraulics Group
Water Resources Services
Technical Service Center
Denver, Colorado

September 1995

ACKNOWLEDGMENTS

The Bureau of Reclamation (Reclamation) prepared and published this report under the supervision of the Sedimentation and River Hydraulics Group. Special thanks to Duane Krogstad and Ken Carlson from the Dakotas Area Office for their assistance, and to Ron Ferrari and Joe Lyons from the Technical Service Center. Lori Lest completed the data processing and generated the new area-capacity tables. Ron Ferrari of the TSC performed the peer review of the study.

U.S. Department of the Interior Mission Statement

As the Nation's principal conservation agency, the Department of the Interior has responsibility for most of our nationally-owned public lands and natural resources. This includes fostering sound use of our land and water resources; protecting our fish, wildlife, and biological diversity; preserving the environmental and cultural values of our national parks and historical places; and providing for the enjoyment of life through outdoor recreation. The Department assesses our energy and mineral resources and works to ensure that their development is in the best interests of all our people by encouraging stewardship and citizen participation in their care. The Department also has a major responsibility for American Indian reservation communities and for people who live in island territories under U.S. administration.

The information contained in this report regarding commercial products or firms may not be used for advertising or promotional purposes and is not to be construed as an endorsement of any product or firm by the Bureau of Reclamation.

The information contained in this report was developed for the Bureau of Reclamation; no warranty as to the accuracy, usefulness, or completeness is expressed or implied.

CONTENTS

	Page
Introduction	1
Summary and conclusions	1
Description of the basin	1
Surveys	2
Survey history	2
Survey methods and equipment	2
Reservoir area and capacity	2
Development of 1991 contour areas	2
1991 revised storage capacity	3
Sediment analyses	3
Sedimentation accumulation	3
Sedimentation summary	3
Reservoir sediment distribution	4
Longitudinal distribution	4
Lateral distribution	4
Depth distribution	4
References	5

TABLES

Table

1 Reservoir sediment data summary (page 1 of 2)	6
1 Reservoir sediment data summary (page 2 of 2)	7
2 Summary of 1991 survey results	8
3 Coordinates of the end points for the range lines	9

FIGURES

Figure

1 Dickinson Dam and Edward Arthur Patterson Lake location map	10
2 Dickinson Dam and Edward Arthur Patterson Lake range location map	11
3 Area and capacity curves for Dickinson Dam and Edward Arthur Patterson Lake	13
4 Edward Arthur Patterson Lake thalweg profiles	14
5 Dickinson Dam ground profile for section R-1	15
6 Dickinson Dam ground profile for section R-2	16
7 Dickinson Dam ground profile for section R-3	17
8 Dickinson Dam ground profile for section R-4	18
9 Dickinson Dam ground profile for section R-5	19
10 Dickinson Dam ground profile for section R-6	20
11 Dickinson Dam ground profile for section R-7	21
12 Dickinson Dam ground profile for section R-8	22
13 Dickinson Dam ground profile for section R-9	23
14 Dickinson Dam ground profile for section R-10	24
15 Dickinson Dam ground profile for section R-11	25
16 Dickinson Dam ground profile for section R-12	26
17 Dickinson Dam ground profile for section R-13	27
18 Dickinson Dam ground profile for section R-14	28
19 Dickinson Dam ground profile for section R-15	29
20 Dickinson Dam ground profile for section R-16	30
21 Dickinson Dam ground profile for section R-17	31
22 Dickinson Dam ground profile for section R-18	32

CONTENTS — CONTINUED

FIGURES — CONTINUED

Figure	Page
23 Dickinson Dam ground profile for section R-19	33
24 Dickinson Dam ground profile for section R-20	34
25 Dickinson Dam ground profile for section R-21	35
26 Dickinson Dam ground profile for section R-22	36
27 Dickinson Dam ground profile for section R-23	37
28 Dickinson Dam ground profile for section R-24	38
29 Dickinson Dam ground profile for section R-25	39
30 Dickinson Dam ground profile for section R-26	40
31 Dickinson Dam ground profile for section R-27	41
32 Dickinson Dam ground profile for section R-28	42
33 Dickinson Dam ground profile for section R-29	43
34 Dickinson Dam ground profile for section R-40	44
35 Dickinson Dam ground profile for section R-50	45
36 Dickinson Dam ground profile for section R-51	46
37 Dickinson Dam ground profile for section R-60	47
38 Dickinson Dam ground profile for section R-61	48
39 Dickinson Dam ground profile for section R-62	49
40 Dickinson Dam ground profile for section R-70	50
41 Dickinson Dam ground profile for section R-71	51
42 Dickinson Dam ground profile for section R-80	52
43 Dickinson Dam ground profile for section R-81	53
44 Dickinson Dam ground profile for section R-82	54
45 Dickinson Dam ground profile for section R-83	55

INTRODUCTION

Dickinson Dam and Reservoir (Edward Arthur Patterson Lake), part of the Dickinson Unit of the Pick-Sloan Missouri Basin, are located on the Heart River in Stark County, 1.5 miles west of Dickinson, North Dakota (fig. 1). The reservoir provides municipal water for Dickinson and downstream irrigators. The reservoir also provides flood control, recreational, and fish and wildlife benefits.

Dickinson Dam was constructed from March 1949 to March 1950. The earthfill dam contains 324,000 cubic yards of material with a structural height* of 62 feet and a crest length of 2,275 feet. The spillway crest elevation was 2,416.5, top of active conservation. Modifications to the dam, completed in 1982, raised the spillway crest 3.5 feet to elevation 2,420.0.

At the time of closure, May 1950, reservoir surface area at the spillway crest, elevation 2,416.5 feet, was about 862 acres with an active capacity of 6,952 acre-feet. Reservoir surface area at elevation 2,420.0 was about 1,194 acres with an active capacity of 10,497 acre-feet. These estimates were developed using Reclamation's ACAP92 (1992) program to determine the change in reservoir storage. These numbers differ from the original area-capacity tables.

The drainage area at Dickinson Dam is about 406 square miles. The basin averages 11 miles in width over the 36 miles upstream from Edward Arthur Patterson Lake.

SUMMARY AND CONCLUSIONS

This report presents the results of an investigation to monitor changes in Edward Arthur Patterson Lake after 41 years of reservoir sediment accumulation.

The NRCS (Natural Resources Conservation Service) State Office, formerly known as the Soil Conservation Service, surveyed the lake in 1991. Standard land surveying techniques were used to survey the lake.

The total storage capacity of the reservoir from the 1991 survey is estimated to be 8,612 acre-feet with a surface area of 1,194 at elevation 2,420.0.

DESCRIPTION OF THE BASIN

Dickinson Dam drainage basin is located in southwestern North Dakota. The area of the basin is 406 square miles. During the 1900s, much of this area was overgrazed. During the drought in the 1930s, stream erosion and channelization increased, but channels have become grass covered and the runoff potential has decreased. The basin is mostly gently rolling farm land with some interspersed pasture land.

Average annual precipitation is about 16 inches, and mean annual runoff is about 19,400 acre-feet. Temperatures range from -37 to 108 °F with a mean temperature of 42 °F.

* The definition of terms such as "structural height," "hydraulic height," etc., may be found in manuals such as Reclamation's *Design of Small Dams* and *Guide for Preparation of Standing Operating Procedures for Dams and Reservoirs*, or ASCE's *Nomenclature for Hydraulics*.

SURVEYS

Survey History

The original sediment ranges were located and surveyed by Reclamation; the survey was started September 1949 and completed in July 1950. In 1991, the reservoir sediment range lines were re-surveyed again by the NRCS.

Survey Methods and Equipment

The 1991 survey was conducted by personnel from the NRCS in Bismarck and their field office in Dickinson. According to the Dakotas Area Office, the NRCS used standard land surveying procedures to profile each range line. Depth readings were taken from a boat using a rod to probe the bottom. The original survey designated the right bank, looking downstream, as the 0+00 station, as did the NRCS survey. Figure 2 displays the surveyed range lines on the original contour map. Also, the original area-capacity curve and table are on the map. Table 3 has the coordinates of the end points for the range lines.

RESERVOIR AREA AND CAPACITY

Development of 1991 Contour Areas

The reservoir was subdivided into segments for sedimentation analysis and to better represent storage changes. The surveyed range lines were used to delineate the limit of each segmental boundary. The method used to compute the new reservoir volume caused by sediment inflow takes the segmented areas (area between the range lines) and determines where the sediment has filled in the original areas. This determination was done by comparing the plots of the original and 1991 range line cross-sections simultaneously. The comparison indicated the lateral distribution of the sediment at the different measured contour elevations. Where these plots indicate changes have occurred on the side slopes of the reservoir, a decision was made to determine whether the change was caused by actual deposition, erosion, or survey inaccuracies. No area adjustment was made if the measured change was judged to be caused by survey inaccuracy. The 1991 surface areas were developed by calculating the 1991 average bottom sediment elevation and comparing it to the original thalweg elevation at each range line. In each segment, the original surface area of each contour elevation that was below the 1991 average bottom sediment elevation was digitized and subtracted from the original area, resulting in the 1991 surface areas. The 1991 total reservoir surface area at a given contour is the original total area minus the summation of all segmental areas silted in at that elevation. The 1991 total area computation results are listed in column (2) of table 2.

The maximum elevation of the reservoir was 2,421.13 feet on June 9, 1982; therefore, no surface area change was assumed to occur above elevation 2,420.0. This assumption is illustrated by the cross-section plots of the range lines which show that the sediment did not accumulate above the spillway crest elevation of 2,420.0. Everything below elevation 2,398.0 has filled in with sediment. The original area-capacity table was done using 4-foot contour intervals from elevation 2,390.0 to 2,430.0 feet; therefore, the new table is consistent with the original.

1991 Revised Storage Capacity

The 1991 surface area and elevation relationships were used as control parameters to compute reservoir capacities by means of Reclamation's area-capacity computer program ACAP92 (Reclamation, 1992). The program computes surface areas for 0.01- to 1.0-foot area increments by linear interpolation between the given contour areas. The respective capacities and capacity equations are then obtained by integration of the area equations. The initial capacity equation is tested over successive intervals to check whether it fits within an allowable error margin. This one equation is used over the whole range that fits within this error term. At the next interval beyond, a new capacity equation (integrated from the basic area equation over that interval) begins testing the fit until it too exceeds the error term. The capacity curve thus becomes a series of curves, each fitting a certain region of data. The final area equations are obtained by differentiation of the capacity equations. Capacity equations are of the form:

$$y = a + a_2x + a_3x^2$$

where:

y = capacity

x = elevation above a reference base

a = intercept

a_2 and a_3 = coefficients

The results of the 1991 area and capacity computations are listed in columns (4) and (5) of table 2. Listed in columns (2) and (3) of this table are the original area and capacity values. To allow comparison of the original capacities with the 1991 capacities, the original capacity values have been revised by using the same curve fitting technique as was used for the 1991 area and capacity computation (ACAP92). Both the original and 1991 area and capacity curves are plotted on figure 3. Area and capacity tables have been published separately for the 0.01-, 0.10-, and 1-foot elevation increments (Reclamation, 1995). The 1991 survey determined that the reservoir has a total storage capacity of 8,612 acre-feet and a surface area of 1,194 acres at spillway crest elevation 2,420.0. The table on the following page contains the dead, inactive, and conservation capacities.

SEDIMENT ANALYSES

Sedimentation Accumulation

Total sediment volume that has accumulated in Edward Arthur Patterson Lake since May 1950 is 1,885 acre-feet at the spillway elevation of 2,420.0. The average annual sediment accumulation rate is 46 acre-feet per year for the 41-year period of operation. Over the contributing basin area, this rate equates to 0.11 acre-feet per square mile per year.

Sedimentation Summary

The results of the sediment data and volume computations for the 1991 survey are shown in tables 1 and 2. The data include a tabulation of incremental sediment inflow volume and sediment accumulation computed for the period between initial conditions and the 1991 resurvey. Table 1 includes information on the drainage basin, records of estimated inflow, reservoir operations, and reservoir storage.

Use	Water Surface Elevation (feet)	Capacity: (acre-feet)			Measured Sediment (acre-feet) (2)-(3)
		(1) Original Capacities after 1981 modification	(2) Original Capacities Computed by ACAP92	(3) 1991 Capacities Computed by ACAP92	
Dead Storage Capacity	2385.0 to 2404.0	1,040	1,049	356	693
Inactive Capacity	2404.0 to 2405.0	195	202	100	102
Conservation Storage Capacity	2405.0 to 2420.0	8,934	9,246	8,156	1,090

- (1) Capacities after the 1981 structural modifications were taken from the Reservoir Capacity Allocations sheet, modified October 1, 1984.
- (2) Original capacities computed using ACAP92.
- (3) 1991 capacities computed using ACAP92 from the 1991 survey.

RESERVOIR SEDIMENT DISTRIBUTION

Longitudinal Distribution

The distribution of sediment throughout the length of the reservoir is illustrated in part by plots of the thalweg profiles representing the original and 1991 resurveyed profiles of the main channel (fig. 4). Field notes describing the location of the thalweg were not available for either survey. Therefore, the lowest elevation at each range line was used as the thalweg.

Lateral Distribution

The 41 range lines originally surveyed in 1950 were resurveyed in 1991. The original and the 1991 range cross-section data are plotted together to depict the changes that have occurred and to represent the general lateral distribution of sediment within the reservoir (figs. 5 to 45). Most of the sediment deposition is located within the historic river channel.

Depth Distribution

The computation of sediment distribution by elevation is given in section 43 of table 1. The entire volume of sediment is below the spillway crest, elevation 2,420.0. About 48 percent of the deposited sediment is found below the top of inactive pool, elevation 2,405.0 feet. The remaining 52 percent of the sediment is found between elevations 2,406.0 and 2,418.0 feet.

REFERENCES

- American Society of Civil Engineers, *Nomenclature for Hydraulics*, ASCE Headquarters, New York, 1962.
- Blanton, J.O. III, *Procedures for Monitoring Reservoir Sedimentation: Technical Guideline for Bureau of Reclamation*, Denver Office, Denver, CO, October 1982.
- Bureau of Reclamation, *Project Data*, Denver Office, Denver, CO, 1981.
- Bureau of Reclamation, Surface Water Branch, *ACAP92 User's Manual*, Technical Service Center, Denver, Colorado, 1992.
- Bureau of Reclamation, *Guide for Preparation of Standing Operating Procedures for Bureau of Reclamation Dams and Reservoirs*, U.S. Government Printing Office, Denver, CO, 1987a.
- Bureau of Reclamation, *Design of Small Dams*, U.S. Government Printing Office, Denver, CO, 1987b.
- Bureau of Reclamation, Technical Service Center, *Edward Arthur Patterson Lake Area and Capacity Tables, Dickinson Unit*, Great Plains Region, Denver, CO, July 1994.

RESERVOIR SEDIMENT
DATA SUMMARY

Dickinson
(Edward Arthur Patterson Lake)
NAME OF RESERVOIR

1
DATA SHEET NO.

D A M	1. OWNER Bureau of Reclamation				2. STREAM Heart River				3. STATE North Dakota					
	4. SEC 18 T 139 N R 96 W				5. NEAREST PO Dickinson, ND				6. COUNTY Stark					
	7. LAT 46° 52' LONG 102° 50'				8. TOP OF DAM 2,436.6'				9. SPILLWAY CREST 2,420.0'					
R E S E R V O I R	10. STORAGE ALLOCATION		11. ELEVATION TOP OF POOL		12. ORIGINAL SURFACE AREA, Ac		13. ORIGINAL CAPACITY, AF		14. GROSS STORAGE ACRE FEET		15. DATE STORAGE BEGAN 5/50			
	a. FLOOD CONTROL		2,430.6 ³		2,092 ⁴		16,708		27,205 ⁵					
	b. MULTIPLE USE													
	c. POWER													
	d. WATER SUPPLY										16. DATE NORMAL OPERATION BEGAN 5/50			
	e. IRRIGATION													
	f. CONSERVATION		2,420.0 ²		1,195 ⁴		9,246		10,497 ⁵					
	g. INACTIVE		2,405.0		216		1,251		1,251 ⁵					
	17. LENGTH OF RESERVOIR 20.6 MILES ⁶								AVG. WIDTH OF RESERVOIR 0.16 MILES					
B A S I N	18. TOTAL DRAINAGE AREA 406 SQ. MI. ⁷								22. MEAN ANNUAL PRECIPITATION 16.3 IN. ⁸					
	19. NET SEDIMENT CONTRIBUTING AREA 406 SQ. MI. ⁷								23. MEAN ANNUAL RUNOFF 1.1 IN.					
	20. LENGTH 36.0 MI. ⁷				AV. WIDTH 11.3 MI.				24. MEAN ANNUAL RUNOFF 19,170 AC.-FT. ¹⁰					
	21. MAX. ELEV. 3,000 FT. ⁹				MIN. ELEV. 2,420 FT. ⁹				25. ANNUAL TEMP. MEAN 42 °F RANGE -37 to 108 °F ⁸					
S U R V E Y D A T A	26. DATE OF SURVEY		27. PER. YRS.	28. ACCL. YRS.	29. TYPE OF SURVEY		30. NO. OF RANGES OR INTERVAL		31. SURFACE AREA, AC.		32. CAPACITY ACRE-FEET		33. C/I RATIO AF/AF	
	1950		0	0	Contour(D)		4 ft.		1,194 ⁴		10,497 ⁵		0.54 ⁹	
	1991		41.0	41.0	Range(D)		41		1,194		8,612		0.44 ⁹	
	26. DATE OF SURVEY		34. PERIOD ANNUAL PRECIP.		35. PERIOD WATER INFLOW, ACRE FEET						36. WATER INFLOW TO DATE, AF			
					a. MEAN ANN.		b. MAX. ANN.		c. TOTAL		a. MEAN ANN.		b. TOTAL	
	1991		16.3 ⁸		19,170 ¹⁰		66,625 ¹⁰		843,502 ¹⁰		19,170 ¹⁰		843,502 ¹⁰	
	26. DATE OF SURVEY		37. PERIOD CAPACITY LOSS, ACRE-FEET						38. TOTAL SEDIMENT DEPOSITS TO DATE, AF					
			a. TOTAL		b. AV. ANN.		c. /MI. ² -YR.		a. TOTAL		b. AV. ANNUAL		c. /MI. ² -YR.	
	1991		1,885		46.0		0.11		1,885		46.0		0.11	
	26. DATE OF SURVEY		39. AV. DRY WT. (#/FT ³)		40. SED. DEP. TONS/MI. ² -YR.				41. STORAGE LOSS, PCT.				42. SED. INFLOW, PPM	
					a. PERIOD		b. TOTAL TO DATE		a. AV. ANNUAL		b. TOTAL TO DATE		a. PER. b. TOT.	
	1991		N/A						0.44		18.0			

Table 1. - Reservoir sediment data summary (page 1 of 2).

26. DATE OF SURVEY	43. DEPTH DESIGNATION RANGE IN FEET BELOW AND ABOVE CREST ELEVATION 2420																													
	-40 to -36		-36 to -32		-32 to -28		-28 to -24		-20 to -16		-16 to -12		-12 to -8		-8 to -4		-4 to 0		0 to 4											
	PERCENT OF TOTAL SEDIMENT LOCATED WITHIN DEPTH DESIGNATION																													
1991	7		8		12		21		25		20		7		0		0		0											
26. DATE OF SURVEY	44. REACH DESIGNATION PERCENT OF TOTAL ORIGINAL LENGTH OF RESERVOIR																													
	0-10		10-20		20-30		30-40		40-50		50-60		60-70		70-80		80-90		90-100		100-105		105-110		110-115		115-120		120-125	
	PERCENT OF TOTAL SEDIMENT LOCATED WITHIN REACH DESIGNATION																													
45. RANGE IN RESERVOIR OPERATION																														
WATER YEAR		MAX.		MIN.		INFLOW, AF		WATER YEAR		MAX.		MIN.		INFLOW, AF																
1952		2419.2		2412.8		-667		1953		2417.2		2412.7		10,808																
1954		2419.6		2411.8		27,896		1955		2418.2		2411.8		12,858																
1956		2415.5		2411.8		2,436		1957		2419.3		2413.0		23,335																
1958		2416.9		2413.7		5,650		1959		2418.5		2413.7		16,867																
1960		2418.0		2413.4		11,284		1961		2414.4		2410.7		244																
1962		2416.6		2410.4		3,752		1963		2417.1		2413.2		12,244																
1964		2417.1		2412.9		6,610		1965		2418.2		2413.6		32,642																
1966		2418.2		2415.1		18,166		1967		2418.2		2412.8		37,613																
1968		2414.2		2412.7		1,654		1969		2418.3		2412.7		50,236																
1970		2420.1		2414.2		42,520		1971		2418.0		2414.4		39,947																
1972		2420.1		2415.9		61,780		1973		2418.1		2413.6		18,601																
1974		2417.0		2413.1		4,094		1975		2418.5		2412.8		41,272																
1976		2416.8		2412.8		8,124		1977		2417.4		2412.5		11,967																
1978		2419.4		2414.8		66,625		1979		2417.9		2413.9		39,012																
1980		2415.7		2411.4		985		1981		2416.8		2410.9		5,934																
1982		2421.0		2414.9		55,353		1983		2420.9		2416.0		27,831																
1984		2420.7		2416.0		17,862		1985		2418.6		2415.6		1,197																
1986		2420.6		2415.6		44,959		1987		2420.8		2418.7		21,744																
1988		2419.7		2413.8		-378		1989		2420.4		2413.3		2,827																
1990		2416.5		2413.5		758		1991		2413.6		2409.3		-81																
1992		2410.6		2408.0		-347		1993		2417.3		2408.0		4,870																
1994		2420.5		2416.0		16,908		1995		unavailable		unavailable		35,510																
46. ELEVATION - AREA - CAPACITY DATA FOR 1950 AND 1991 ¹																														
ELEV.		AREA		CAP		ELEV.		AREA		CAP.		ELEV.		AREA		CAP.														
1950 (Min. elev. 2,390.0') ²						1991 (Min. elev. 2,390.0') ³																								
2390		17		19 ⁴		2418		979		8,323 ⁵		2390		0		0		2418		978		6,440								
2394		39		131 ⁵		2420		1,194		10,497 ⁵		2394		0		0		2420		1,194		8,612								
2398		63		335 ⁵		2422		1,410		13,101 ⁵		2398		28		56		2422		1,410		11,216								
2402		133		727 ⁵		2426		1,775		19,471 ⁵		2402		51		214		2426		1,775		17,586								
2406		244		1,481 ⁵		2430		2,092		27,205 ⁵		2406		130		576		2430		2,092		25,320								
2410		432		2,833 ⁵								2410		309		1,454														
2414		667		5,031 ⁵								2414		603		3,278														
47. REMARKS AND REFERENCES																														
¹ Crest of dam after 1981 modifications to the crest of the dam and spillway.																														
² Top of active conservation as of 1981.																														
³ Top of surcharge, maximum water surface elevation, as of 1981.																														
⁴ Surface areas interpolated from original surface areas, 1950.																														
⁵ Capacity values recomputed using original surface areas and current methods (ACAP92) for comparison with 1991 values to compute sediment deposition.																														
⁶ Channel lengths at elevation 2430 feet: Main channel - 12.1 miles, Tributaries - 0.5, 1.1, 1.3, 2.8, 2.8 miles																														
⁷ Probable Maximum Flood for Dickinson Dam, February 22, 1990, Reclamation.																														
⁸ Project Data Book, Reclamation.																														
⁹ Capacity/Inflow; inflow is from item no. 24.																														
¹⁰ Calculated from the inflow data provided by the Dakotas Area Office, complete list of data in item 45.																														
48. AGENCY MAKING SURVEY Natural Resources Conservation Service State Office																														
49. AGENCY SUPPLYING DATA Bureau of Reclamation, Dakotas Area Office											DATE 9/95																			

Table 1. - Reservoir sediment data summary (page 2 of 2).


(1) Elevation (feet)	(2) Original Area (acres)	(3) Original Capacity (acre- feet)	(4) 1991 Area (acres)	(5) 1991 Capacity (acre- feet)	(6) Measured Sediment Volume (acre-feet)	(7) Percent Measured Sediment	(8) Percent Reservoir Depth
2430	2092	27205	2092	25320	1885	100	100
2426	1775	19471	1775	17586	1885	100	90
2422	1410	13101	1410	11216	1885	100	80
2420	1194	10497	1194	8612	1885	100	75
2418	979	8323	978	6440	1883	100	70
2414	667	5031	603	3278	1753	93	60
2410	432	2833	309	1454	1379	73	50
2406	244	1481	130	576	905	48	40
2402	133	727	51	214	513	27	30
2398	63	335	28	56	279	15	20
2394	39	131	0	0	131	7	10
2390	17	19	0	0	19	1	0

- (1) Elevation of reservoir water surface.
- (2) Original reservoir surface area from the 1950 survey.
- (3) Original calculated reservoir capacity computed using ACAP92 from original measured surface areas.
- (4) Reservoir surface area from 1991 survey.
- (5) 1991 calculated reservoir capacity computed using ACAP92 from 1991 surface areas.
- (6) Measured sediment volume = column (3) - column (5).
- (7) Measured sediment expressed in percentage of total sediment (1885 acre-feet).
- (8) Depth of reservoir expressed in percentage of total depth (40 feet).

Table 2. - Summary of 1993 survey results.

Range	Right Bank			Left Bank		
	State Plane North	State Plane East	Elevation (feet)	State Plane North	State Plane East	Elevation (feet)
R-1	20,832.3	48,357.2	2432.2	22,498.0	48,245.1	2434.7
R-2	20,720.5	47,924.4	2434.9	21,711.9	46,948.2	2436.1
R-3	19,405.5	47,465.7	2449.1	21,330.6	45,580.7	2436.8
R-4	19,745.7	44,550.5	2439.1	21,107.0	43,748.3	2436.0
R-5	18,182.0	43,629.1	2432.3	20,946.1	39,926.6	2436.9
R-6	16,404.0	41,729.2	2448.0	19,262.0	39,177.6	2420.2
R-7	14,018.6	39,122.1	2441.4	19,282.0	36,716.8	2431.7
R-8	14,031.9	37,109.2	2438.8	18,053.0	35,343.8	2429.2
R-9	17,396.5	34,885.5	2423.5	17,814.0	34,829.1	2430.9
R-10	14,023.6	33,621.4	2440.7	16,839.3	33,728.2	2435.2
R-11	16,981.9	32,204.5	2421.8	17,379.6	32,608.3	2438.4
R-12	16,981.9	32,204.5	2421.8	16,895.1	31,887.6	2427.9
R-13	16,328.0	32,931.4	2427.4	16,202.4	32,620.7	2422.8
R-14	15,359.9	32,833.6	2427.8	15,500.8	32,350.7	2419.6
R-15	15,500.8	32,350.7	2419.6	15,863.0	31,109.1	2427.9
R-16	16,257.6	31,943.6	2424.6	16,450.4	32,020.0	2428.3
R-17	16,127.1	31,267.6	2425.8	16,118.0	31,063.1	2428.2
R-18	14,930.2	31,378.9	2460.8	15,371.4	31,035.2	2428.0
R-19	16,085.9	30,345.0	2450.5	15,863.0	31,109.1	2427.9
R-20	16,313.3	30,766.5	2427.1	16,508.8	31,128.9	2429.3
R-21	16,085.9	30,345.0	2450.5	16,548.0	30,017.8	2428.8
R-22	17,097.2	29,960.8	2431.5	17,034.8	30,141.1	2432.6
R-23	17,971.4	30,484.0	2429.2	17,951.0	30,677.7	2432.1
R-24	18,457.2	30,283.1	2429.2	18,493.1	30,530.6	2441.6
R-25	18,396.4	29,554.0	2439.0	18,902.7	29,554.8	2432.6
R-26	18,811.6	29,012.1	2427.7	18,848.9	29,234.1	2433.3
R-27	19,302.8	28,815.2	2430.5	19,303.1	28,466.3	2432.9
R-28	19,303.4	28,183.5	2430.7	19,303.1	28,466.3	2432.9
R-29	17,438.9	25,173.5	2440.6	17,555.6	25,162.1	2438.0
R-40	20,715.5	49,768.5	2435.5	20,832.3	48,357.2	2432.2
R-50	22,168.2	47,355.2	2434.8	22,619.5	48,106.6	2433.2
R-51	23,556.6	45,412.9	2472.6	23,879.3	46,553.0	2454.9
R-60	19,431.0	45,486.2	2438.5	19,745.7	44,550.5	2439.1
R-61	18,131.8	46,269.0	2434.3	17,822.7	45,479.0	2435.4
R-62	16,976.1	46,725.2	2436.9	16,884.1	46,085.0	2434.5
R-70	21,583.7	39,369.1	2453.5	21,996.9	40,506.9	2444.2
R-71	23,145.2	39,427.4	2440.3	22,836.5	40,282.5	2471.8
R-80	15,640.6	41,342.9	2438.8	14,018.6	39,122.1	2441.4
R-81	14,114.8	42,383.2	2446.9	13,315.9	41,159.4	2432.5
R-82	12,609.6	41,046.7	2430.5	12,884.2	40,731.6	2434.3
R-83	11,312.8	41,707.8	2438.0	11,487.1	40,825.2	2434.7
R-84	16,315.7	32,485.8	2425.2	16,530.2	32,486.4	2426.4
R-85	16,289.0	32,635.8	2427.5	16,674.9	32,635.3	2424.6

Table 3. - Coordinates of the end points for the range lines.

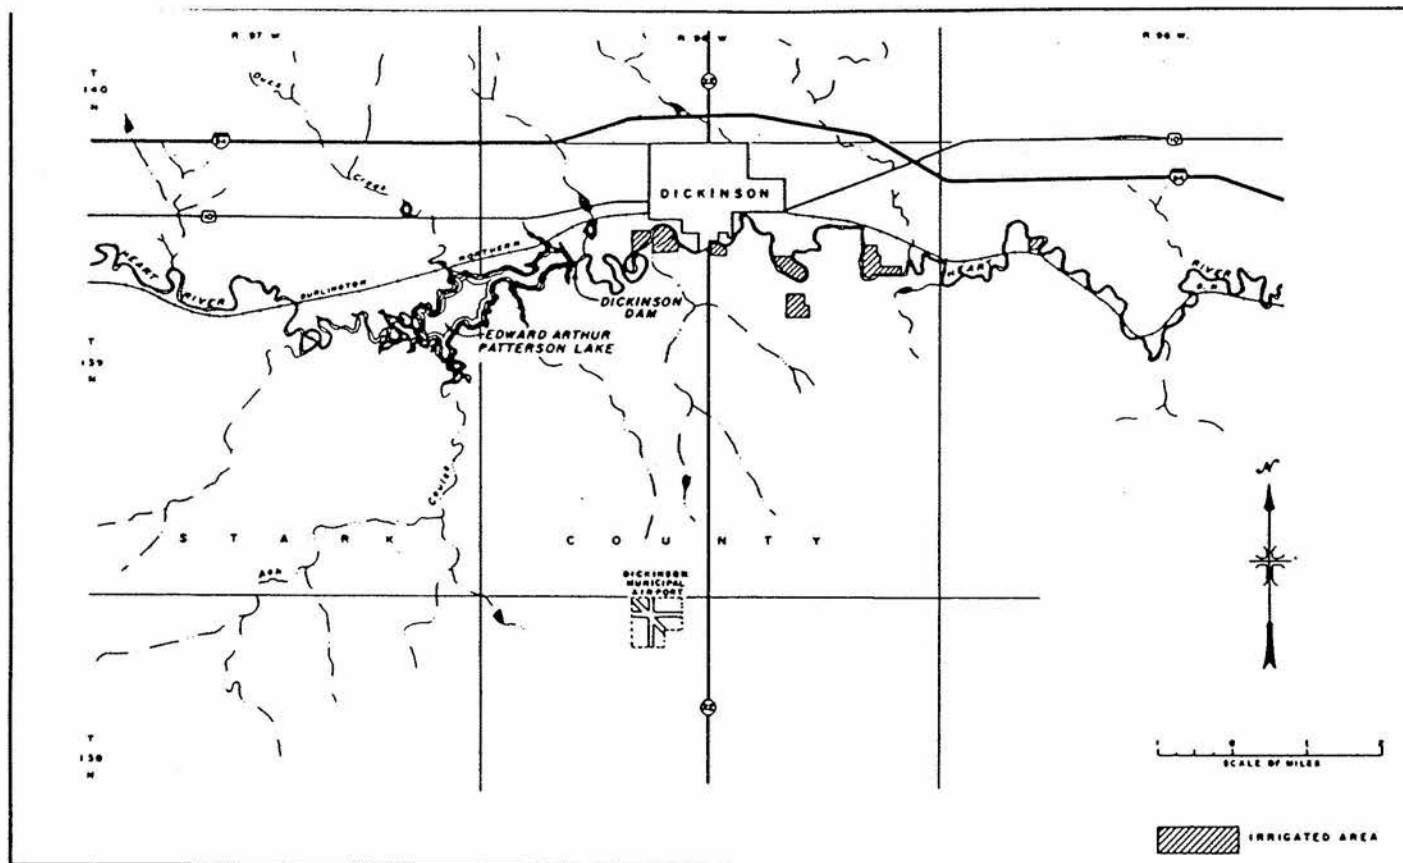

Dickinson Unit



Figure 1. - Dickinson Dam and Edward Arthur Patterson Lake location map.

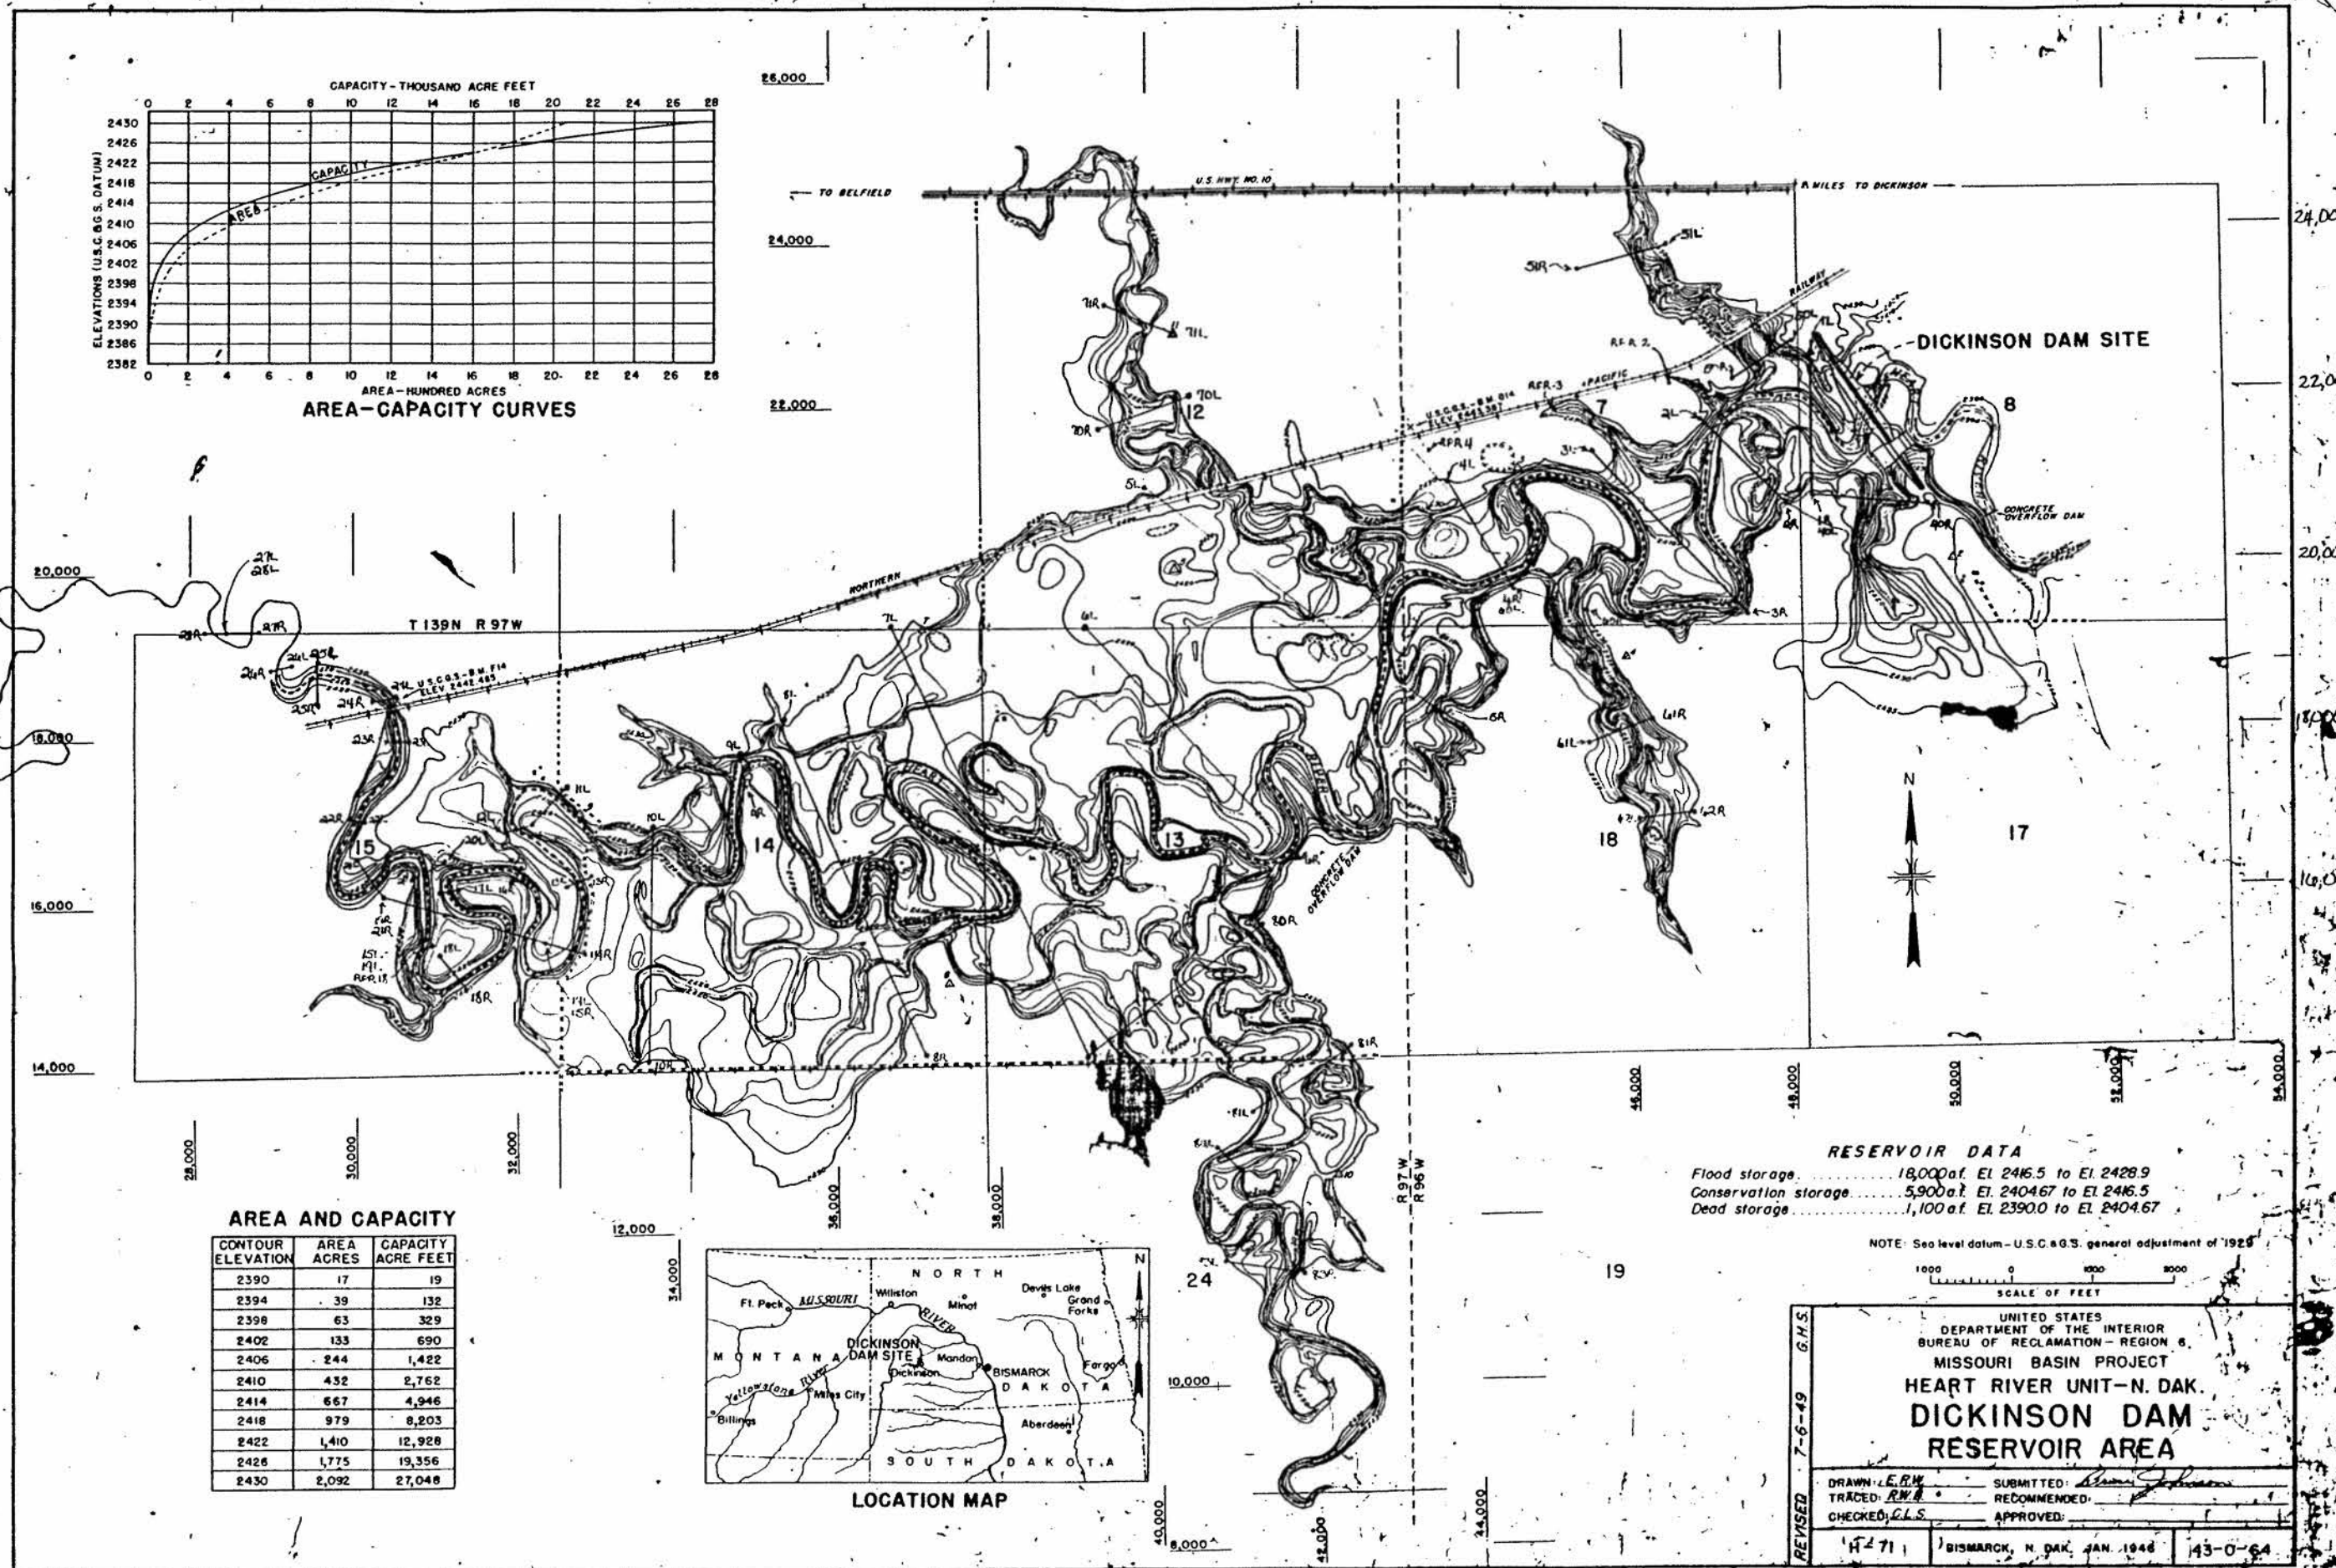


Figure 2. - Dickinson Dam and Edward Arthur Patterson Lake range location map.

Area-Capacity Curves, Dickinson Dam, North Dakota

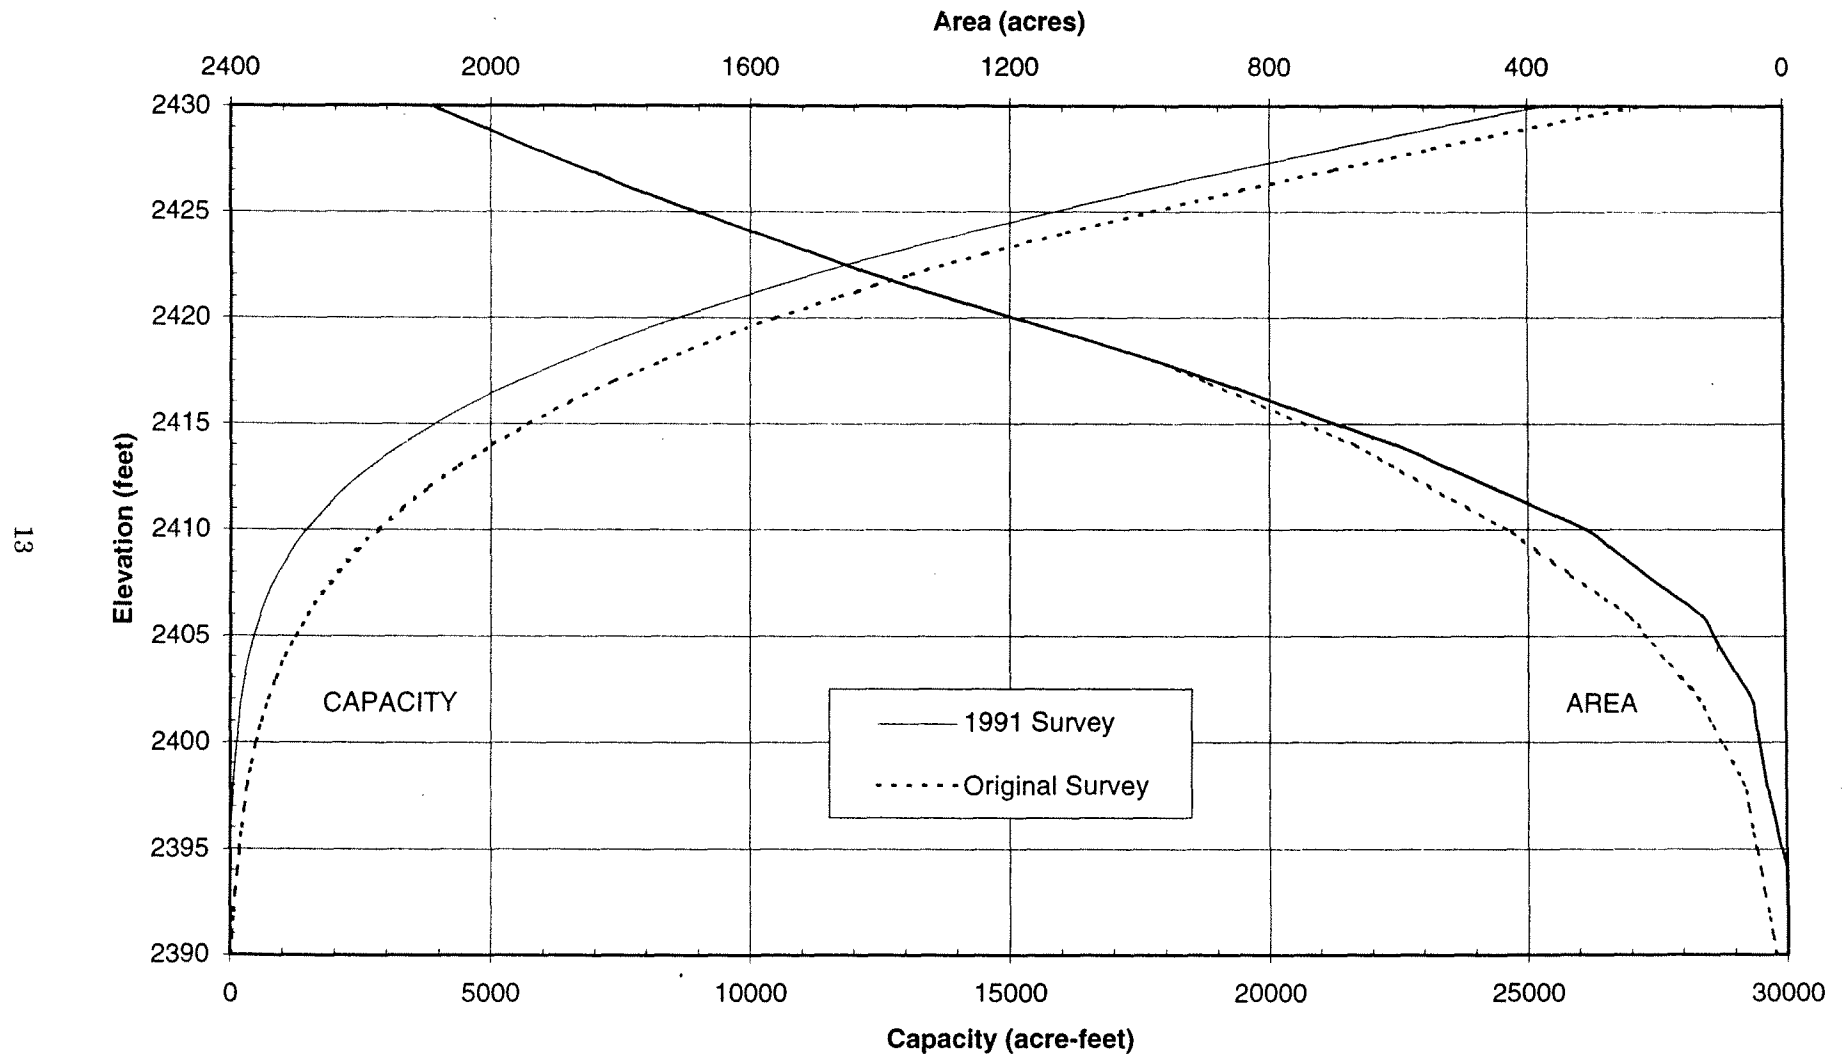


Figure 3. - Area and capacity curves for Dickinson Dam and Edward Arthur Patterson Lake.

Ground Profile

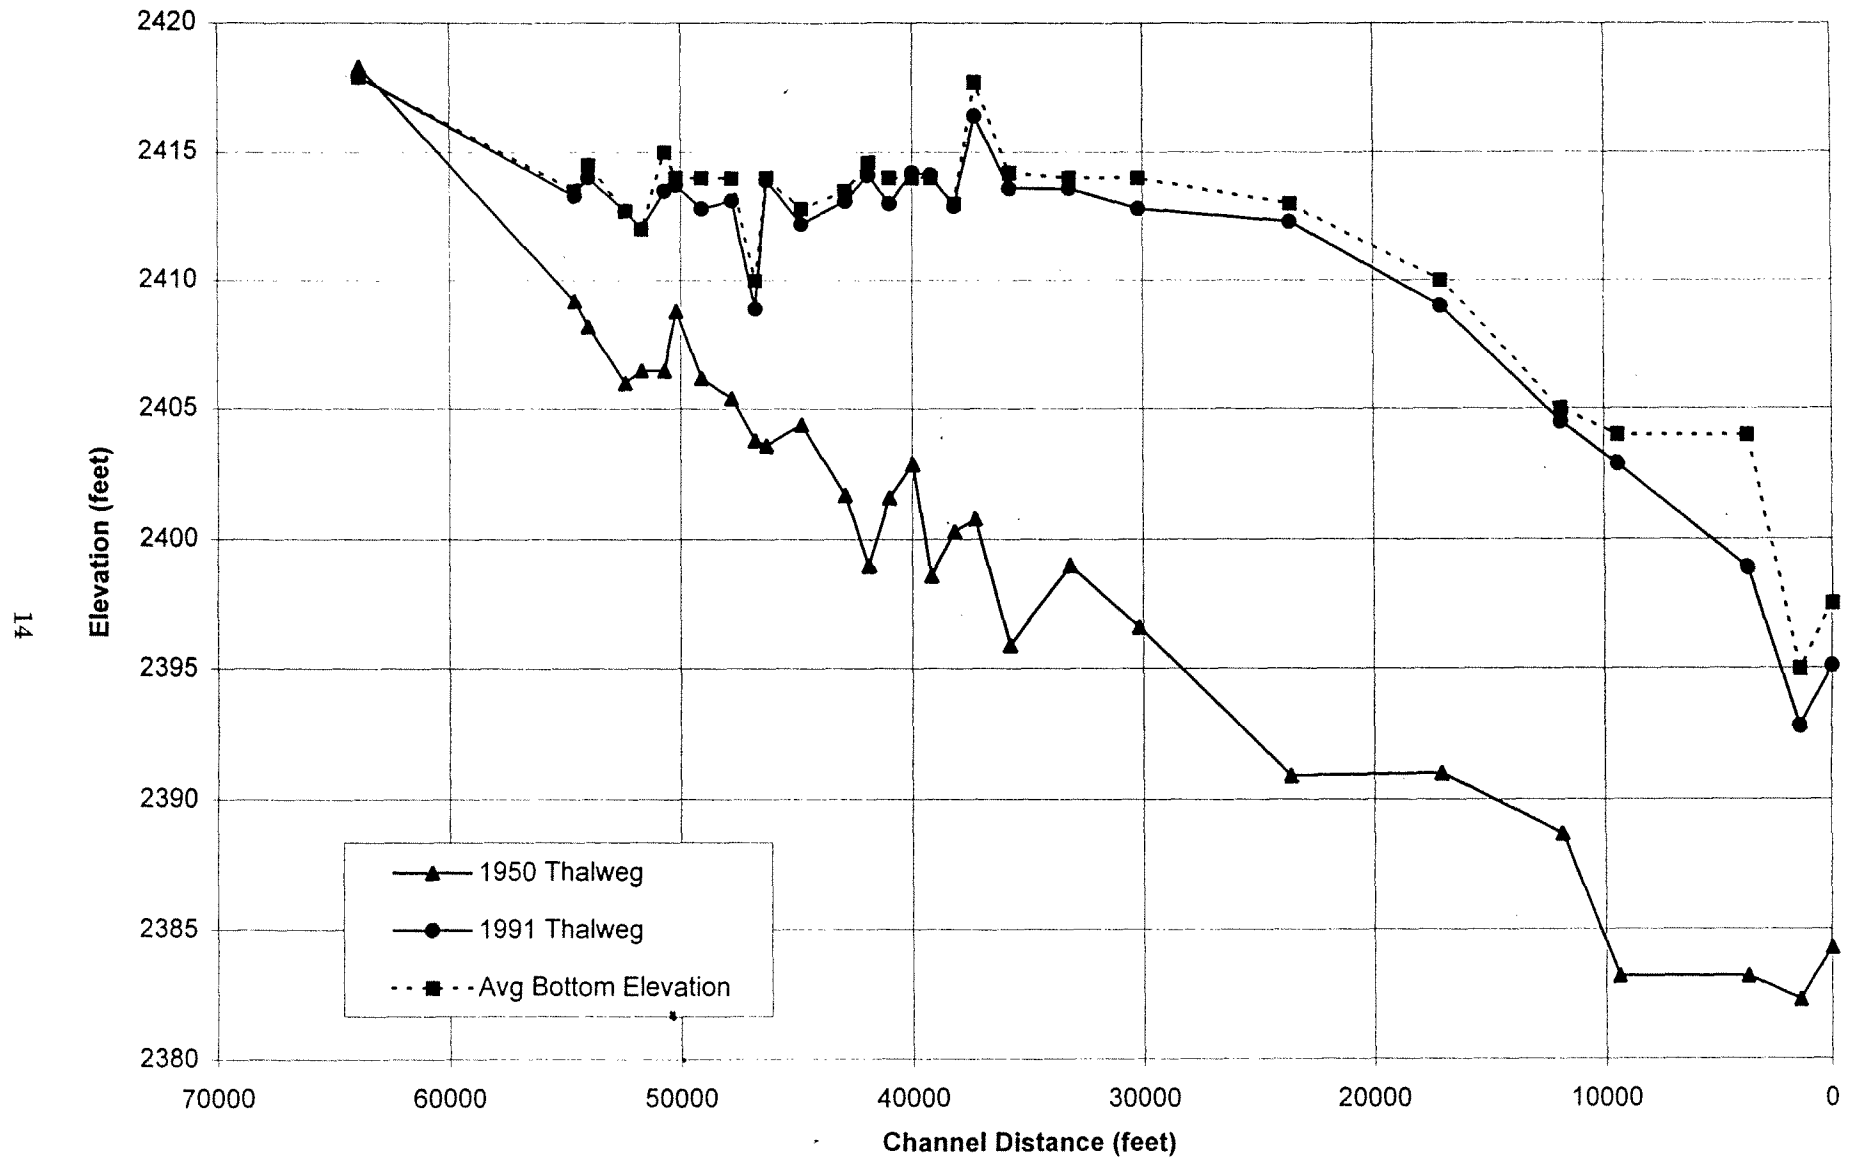


Figure 4. - Edward Arthur Patterson Lake, thalweg profiles.

Dickinson Dam GROUND PROFILE FOR SECTION R-1

———— 1951 Survey - - - - - 1991 Survey

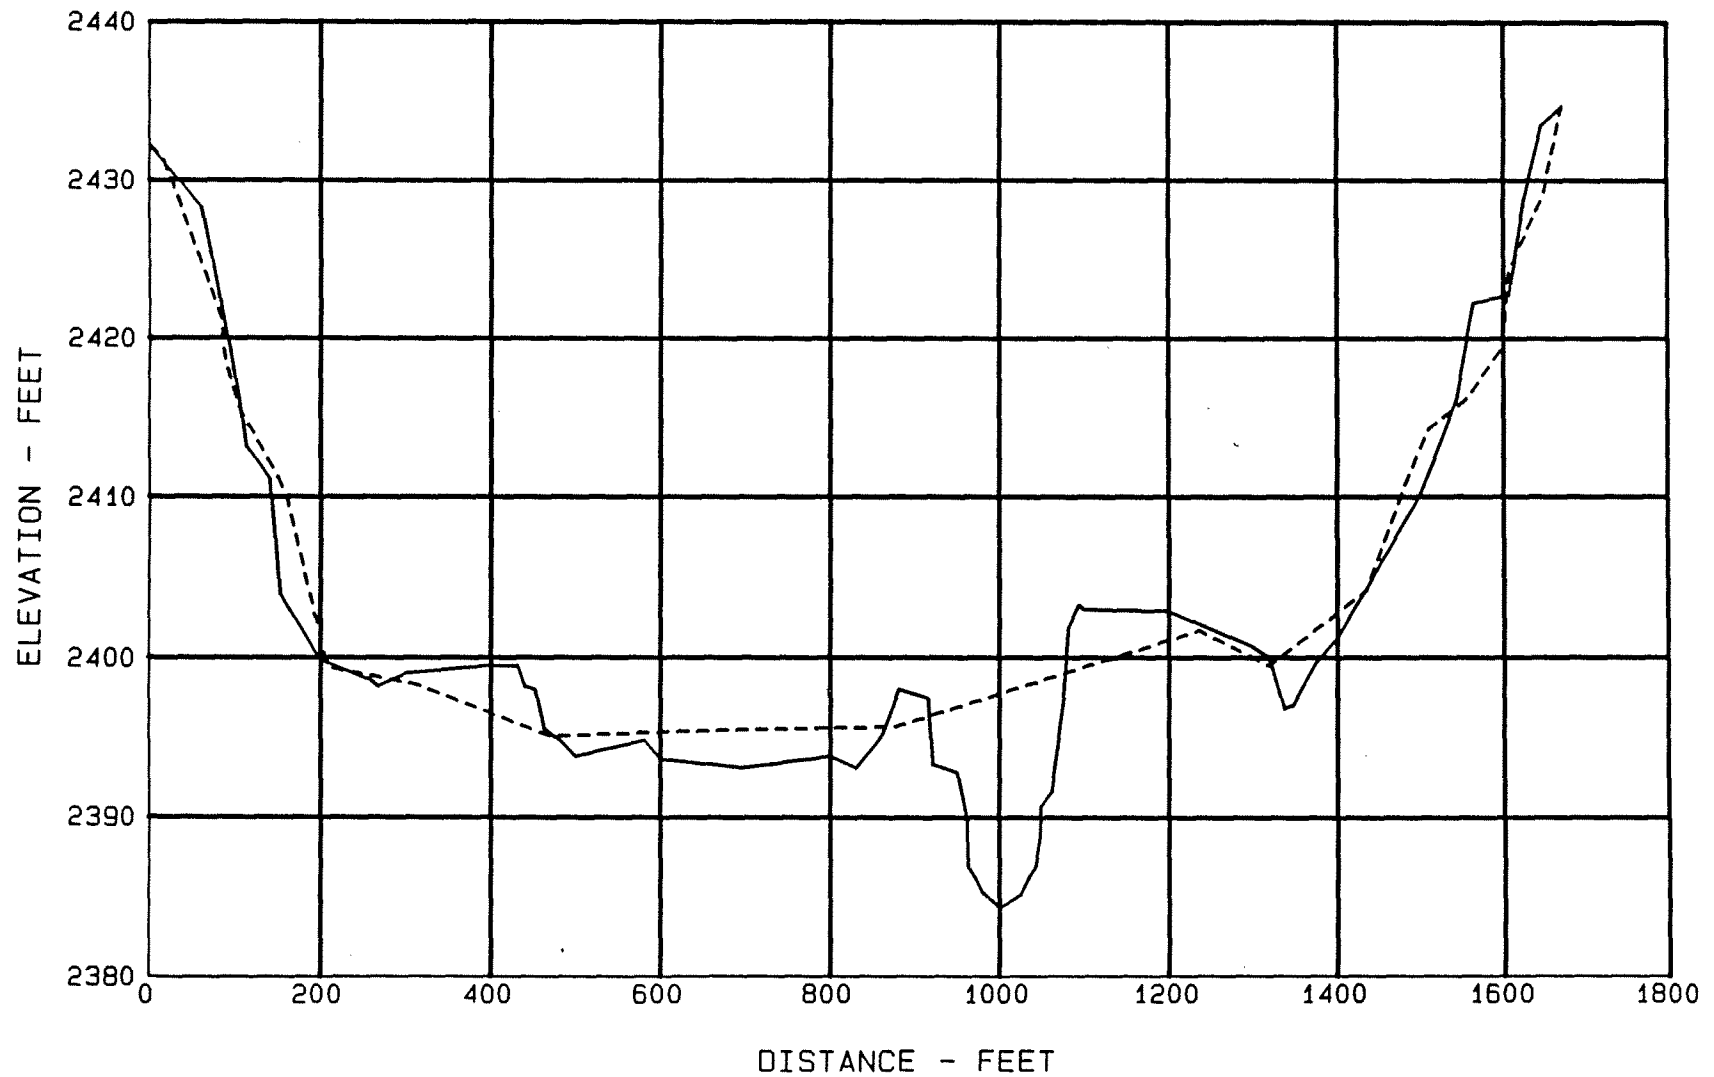


Figure 5. - Dickinson Dam ground profile for section R-1.

Dickinson Dam GROUND PROFILE FOR SECTION R-2

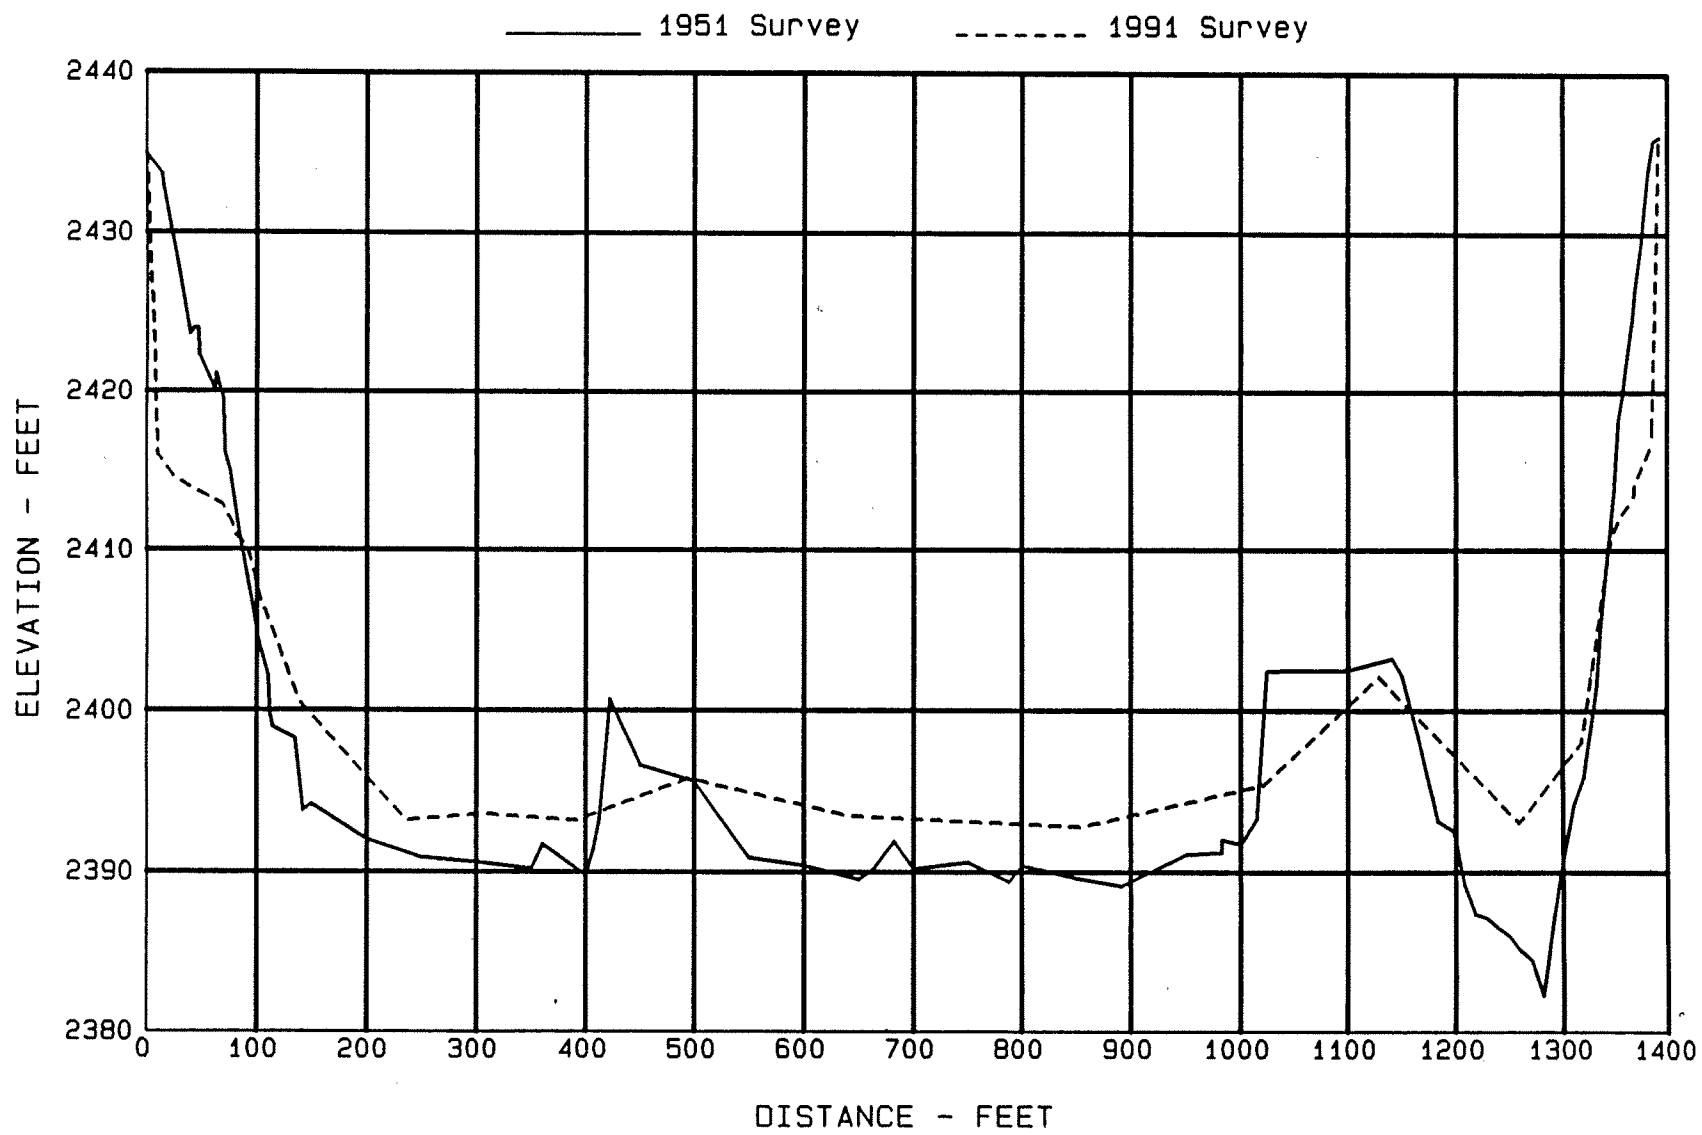


Figure 6. - Dickinson Dam ground profile for section R-2.

Dickinson Dam
GROUND PROFILE FOR SECTION R-3

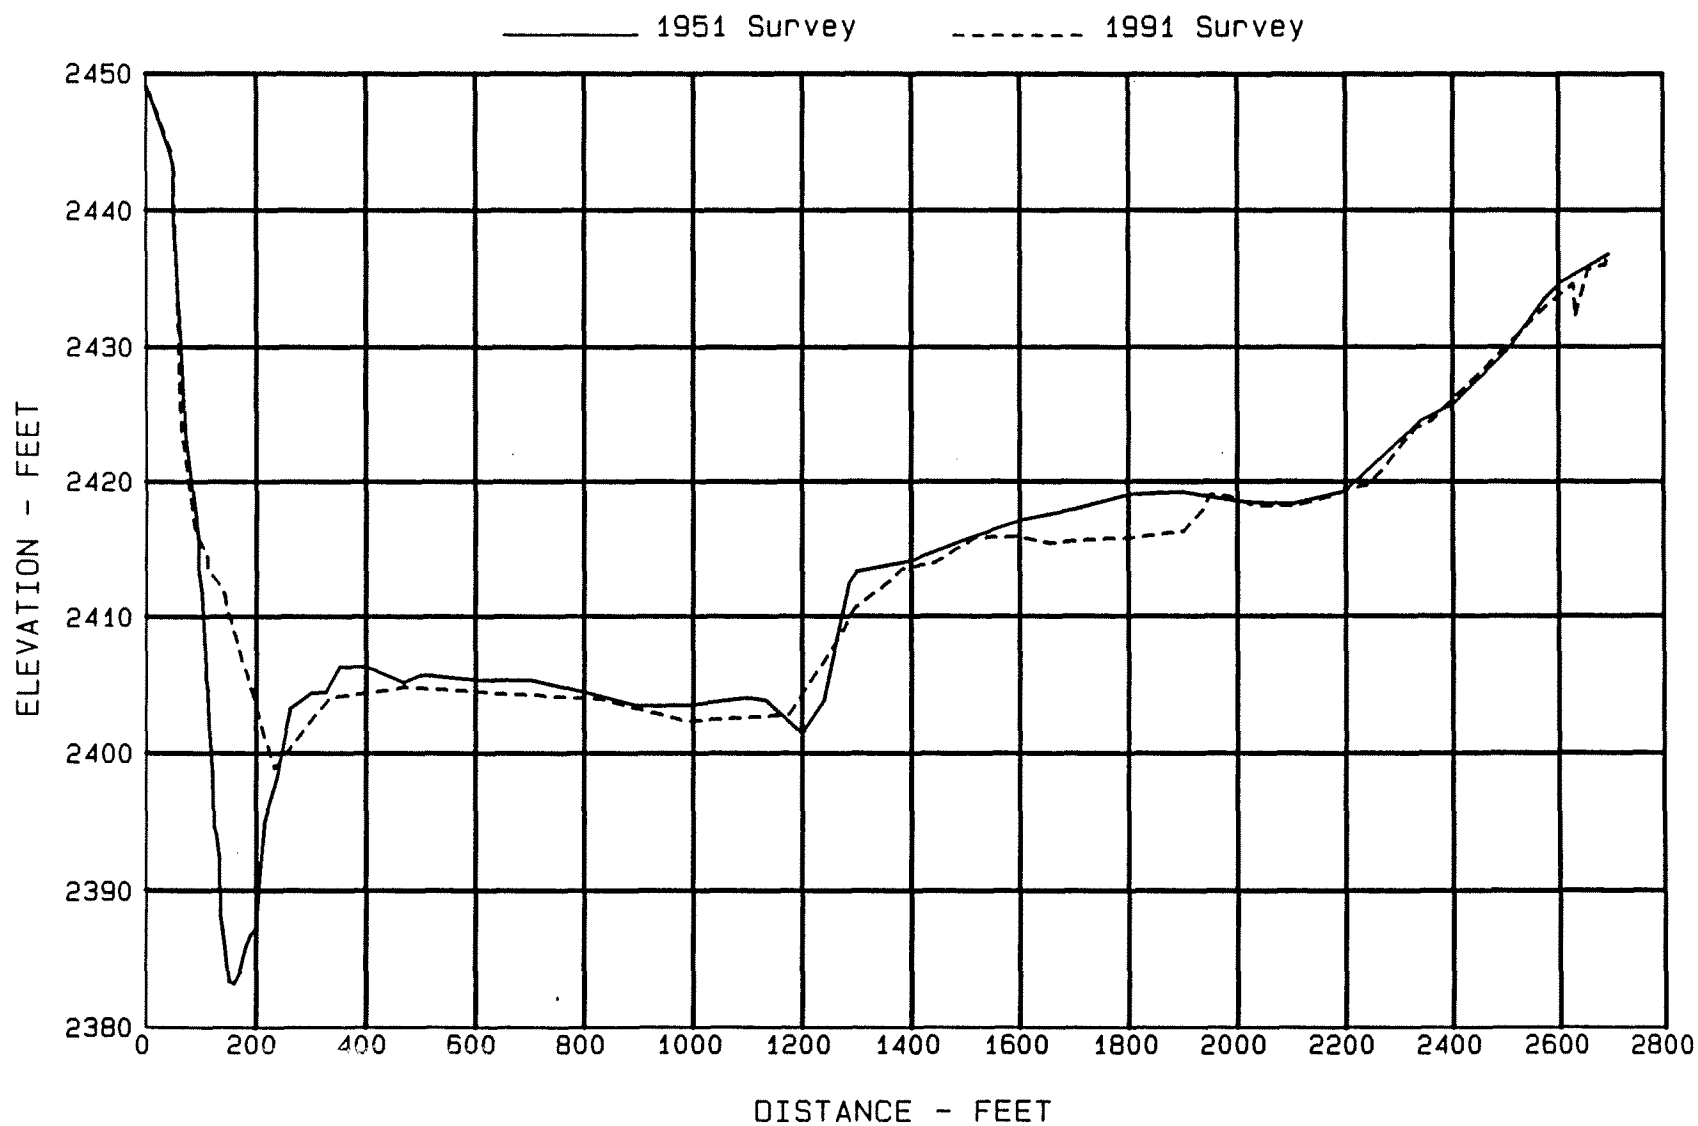


Figure 7. - Dickinson Dam ground profile for section R-3.

Dickinson Dam
GROUND PROFILE FOR SECTION R-4

———— 1951 Survey - - - - - 1991 Survey

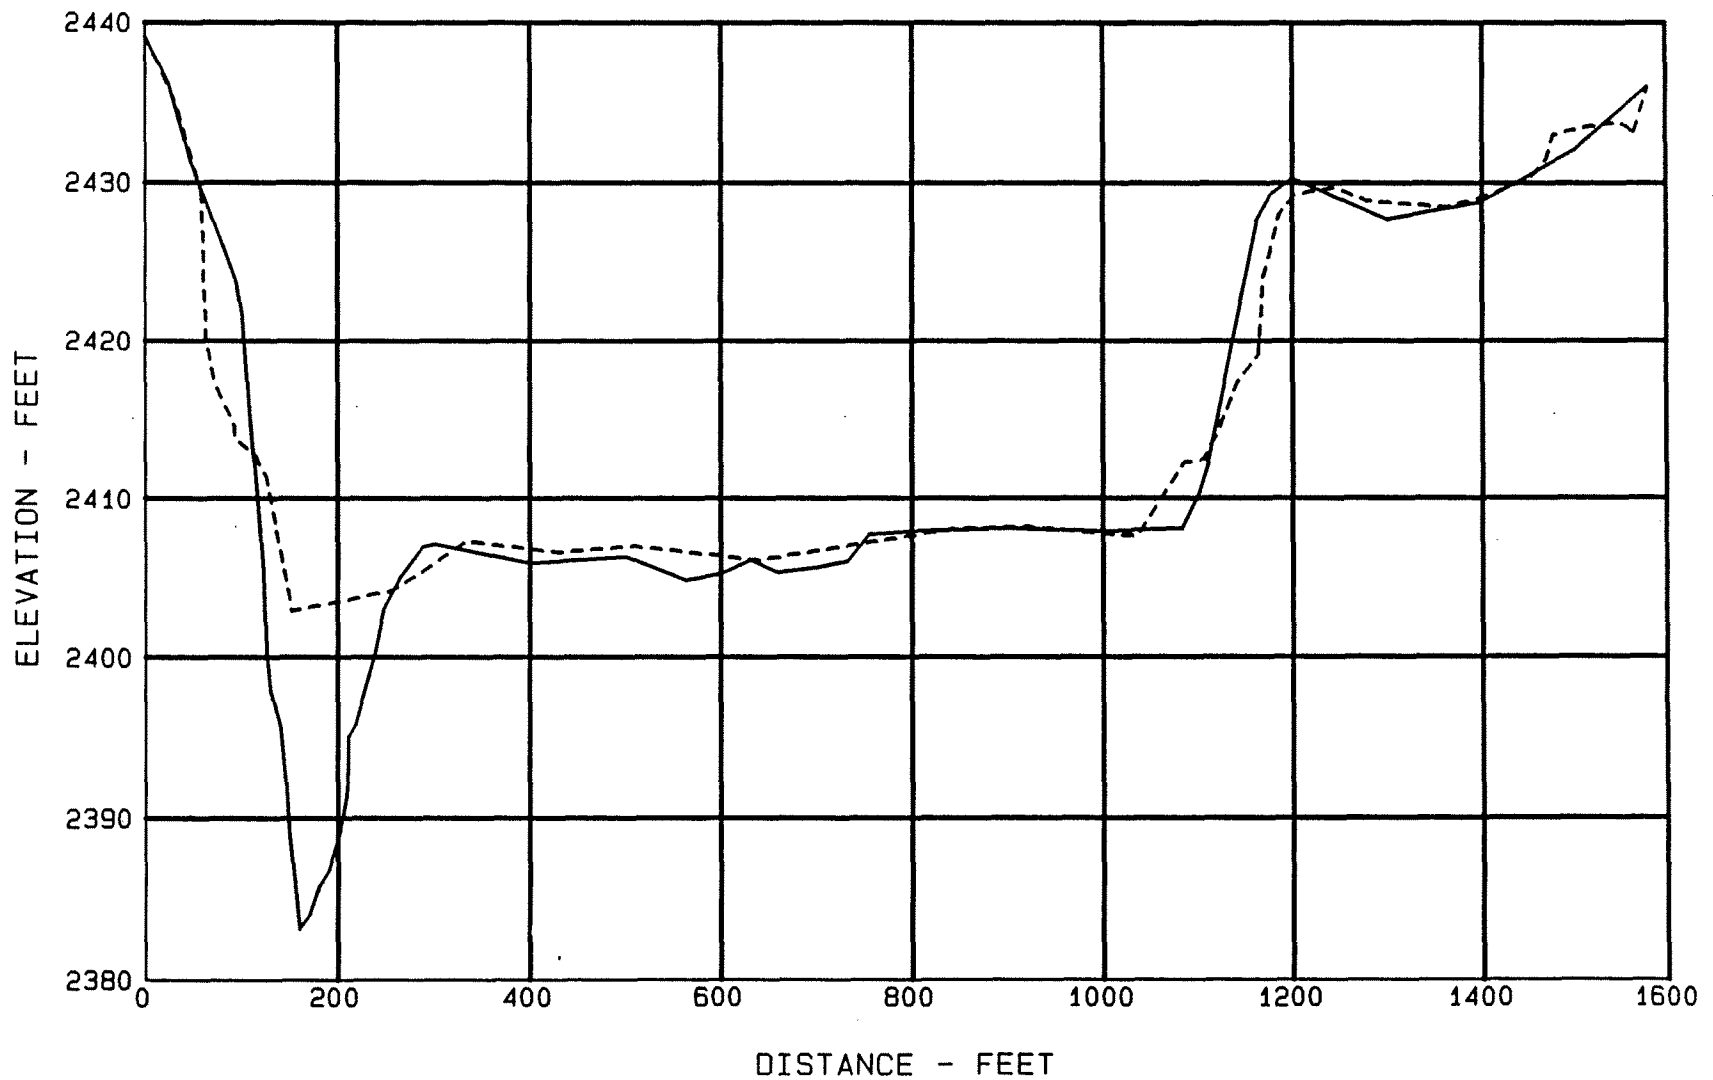


Figure 8. - Dickinson Dam ground profile for section R-4.

Dickinson Dam
GROUND PROFILE FOR SECTION R-5

———— 1951 Survey - - - - - 1991 Survey

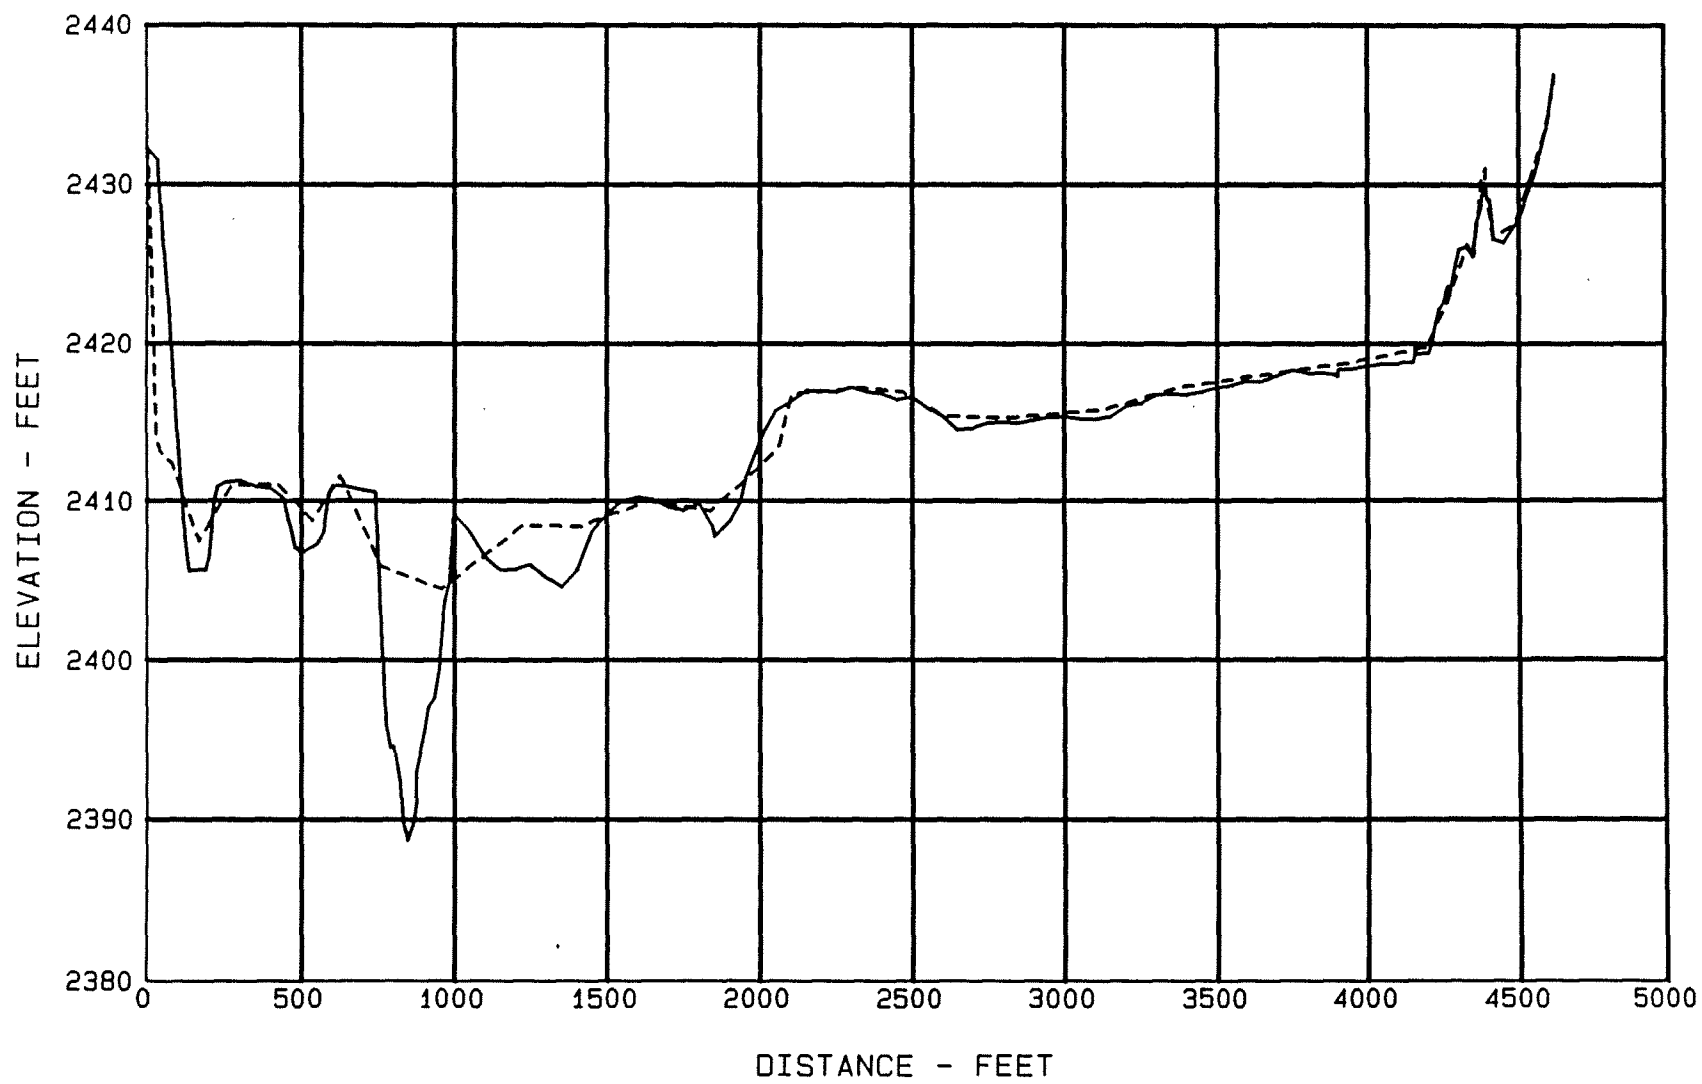


Figure 9. - Dickinson Dam ground profile for section R-5.

Dickinson Dam
GROUND PROFILE FOR SECTION R-6

———— 1951 Survey - - - - - 1991 Survey

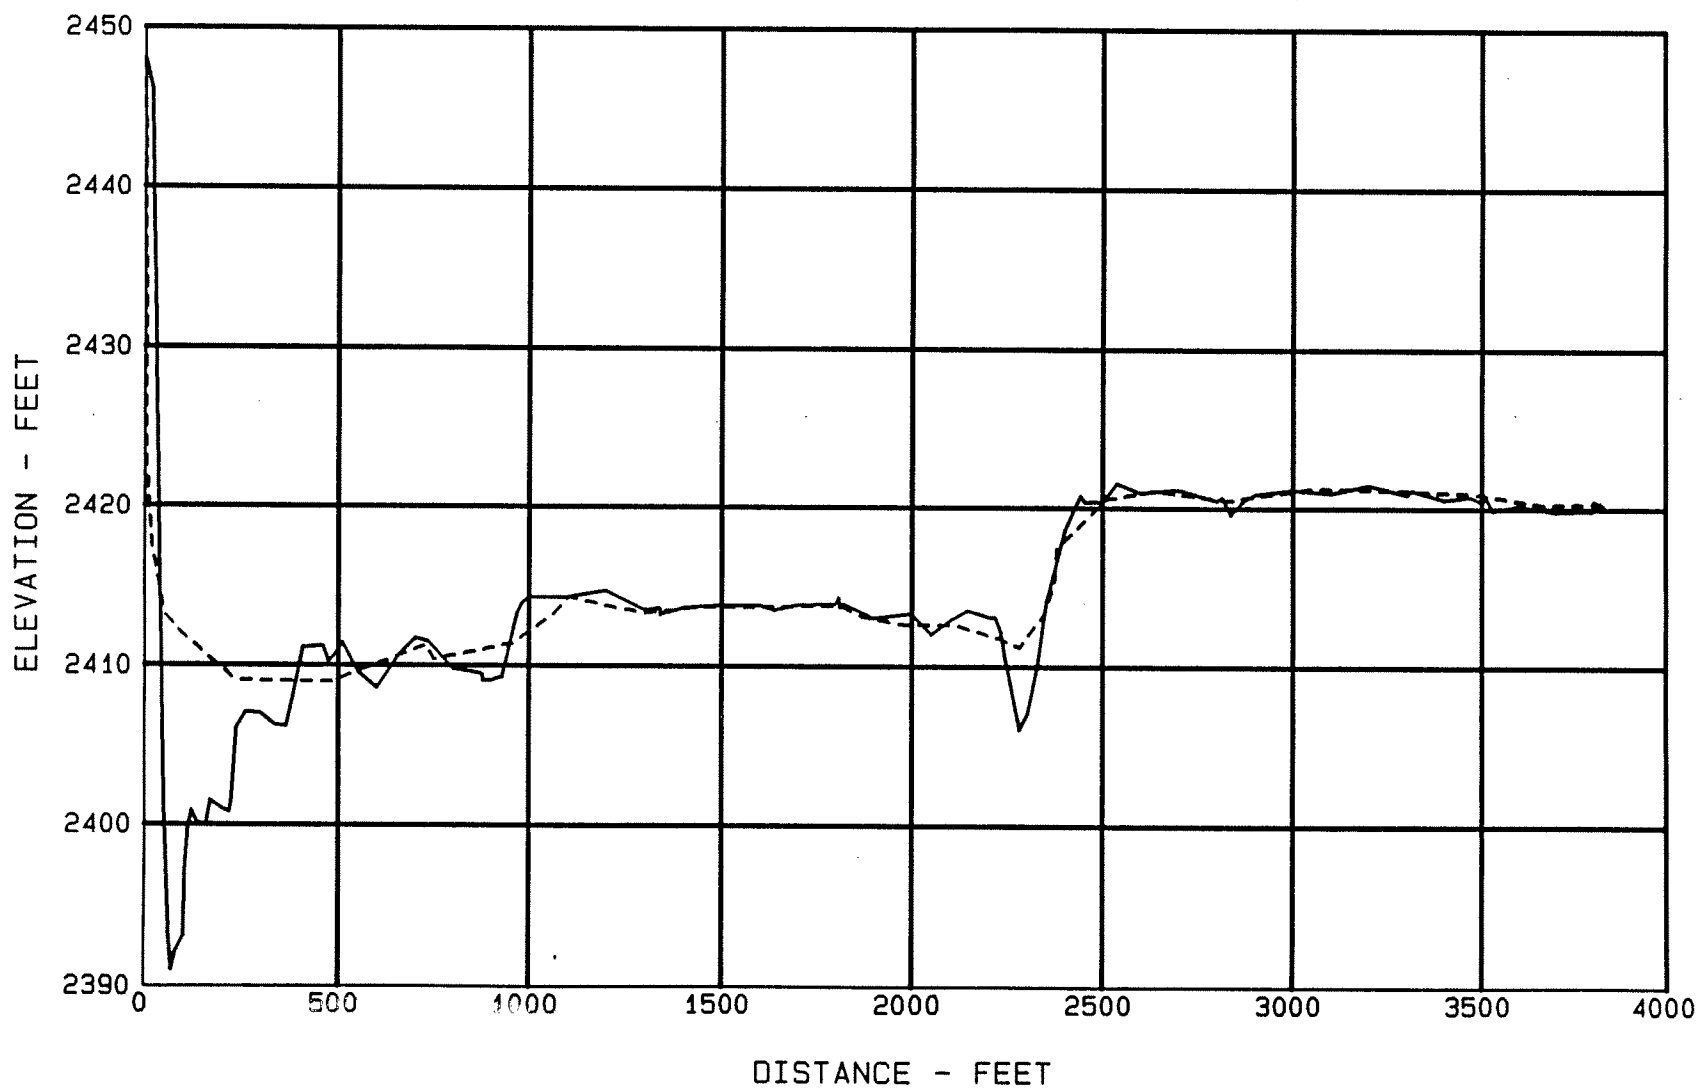


Figure 10. - Dickinson Dam ground profile for section R-6.

Dickinson Dam
GROUND PROFILE FOR SECTION R-7

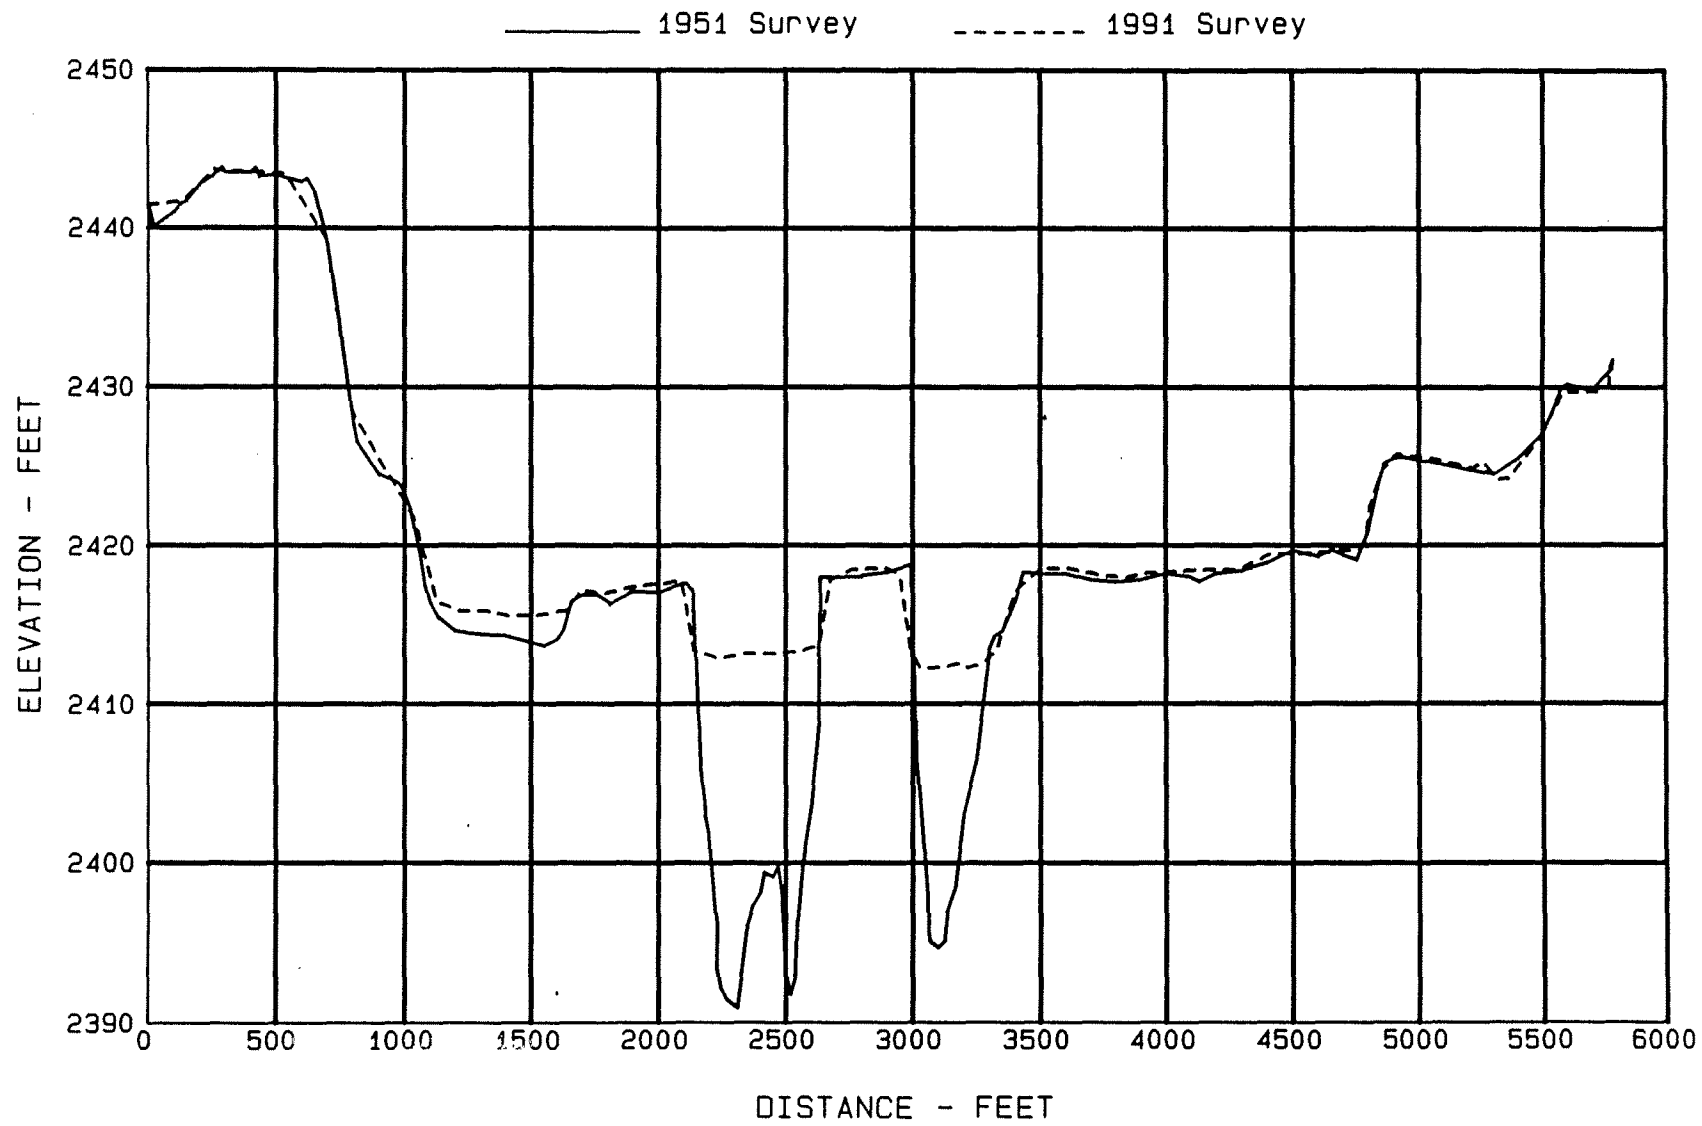


Figure 11. - Dickinson Dam ground profile for section R-7.

Dickinson Dam
GROUND PROFILE FOR SECTION R-8

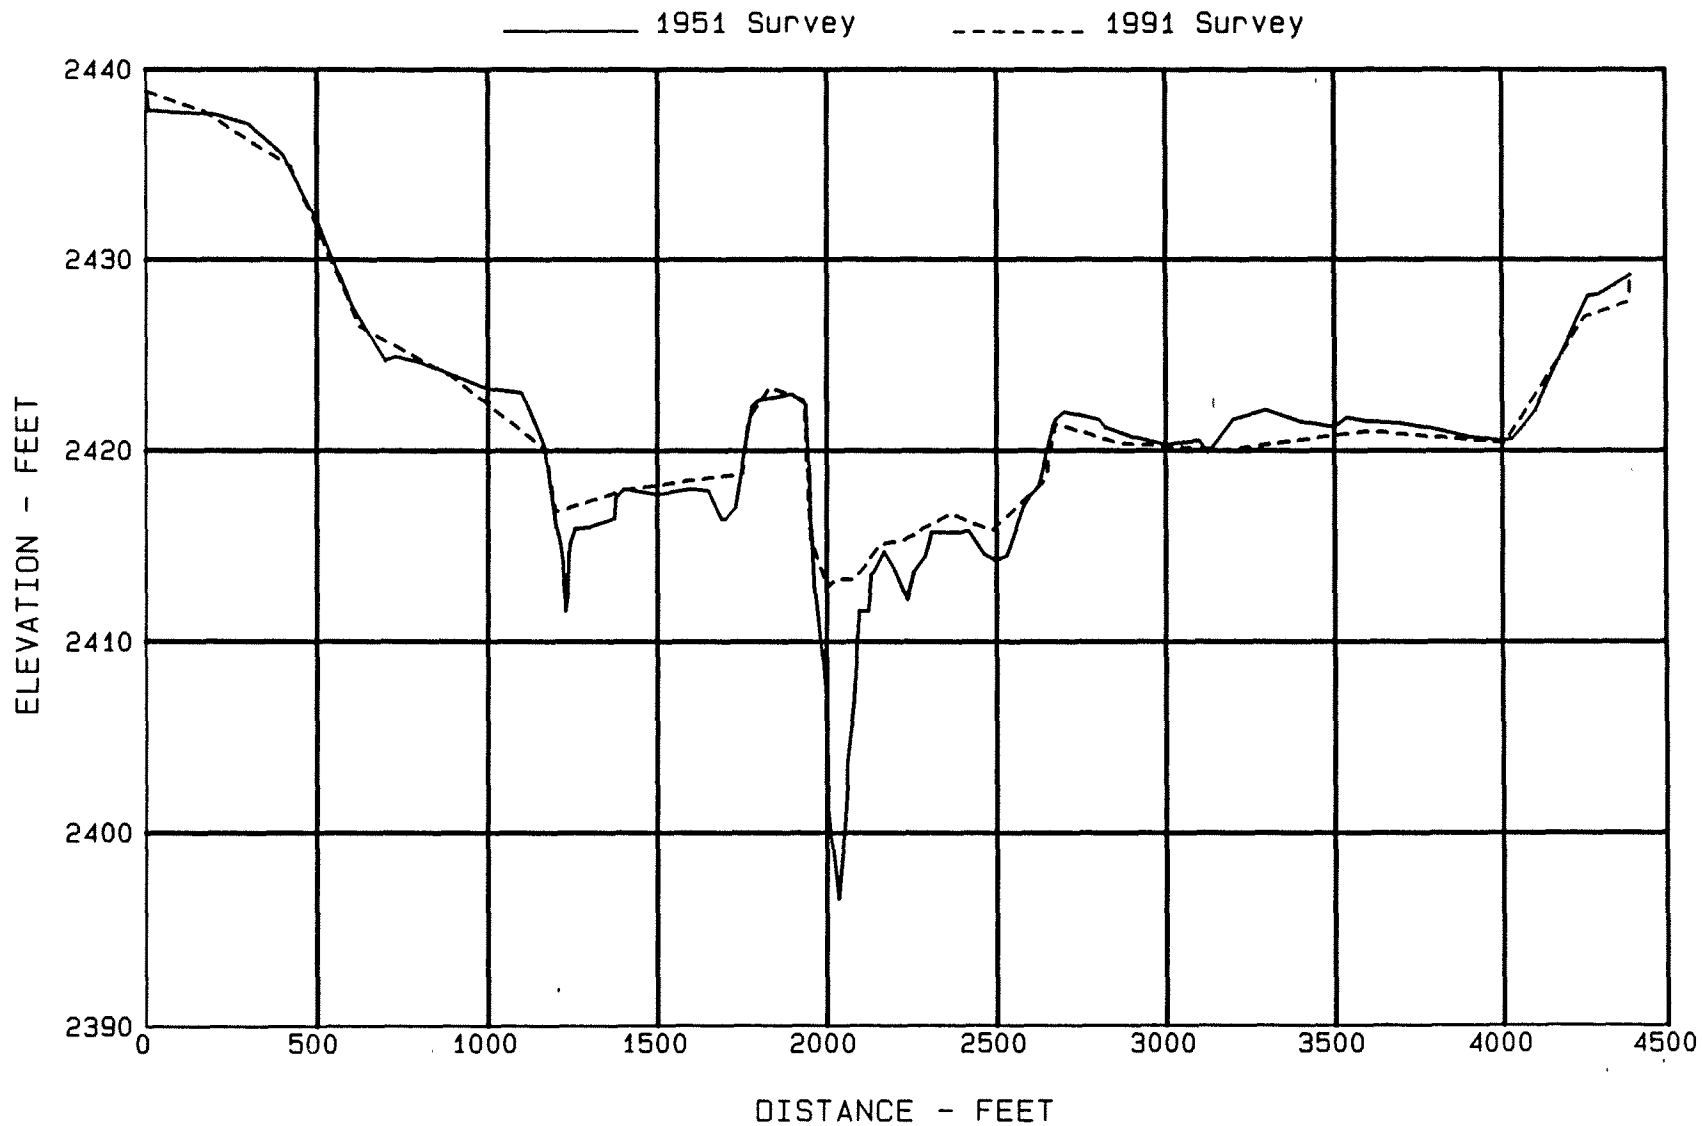


Figure 12. - Dickinson Dam ground profile for section R-8.

Dickinson Dam
GROUND PROFILE FOR SECTION R-9

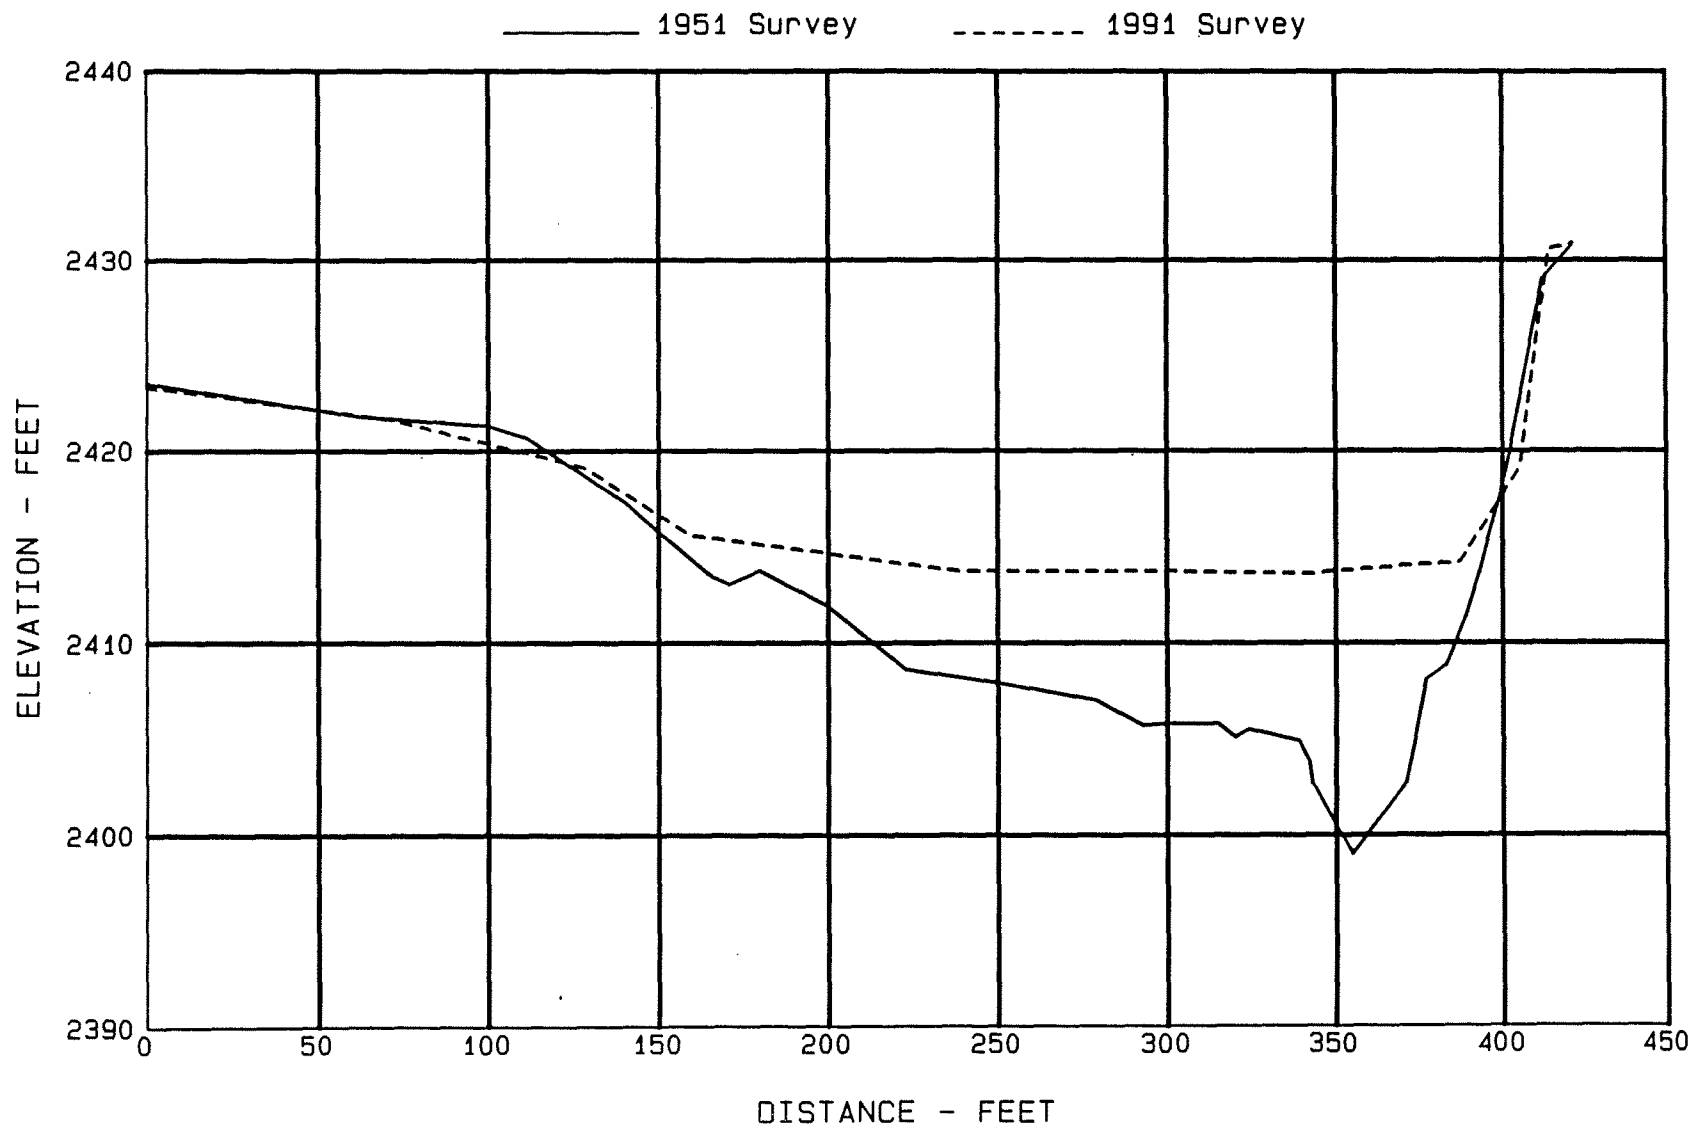


Figure 13. - Dickinson Dam ground profile for section R-9.

Dickinson Dam
GROUND PROFILE FOR SECTION R-10

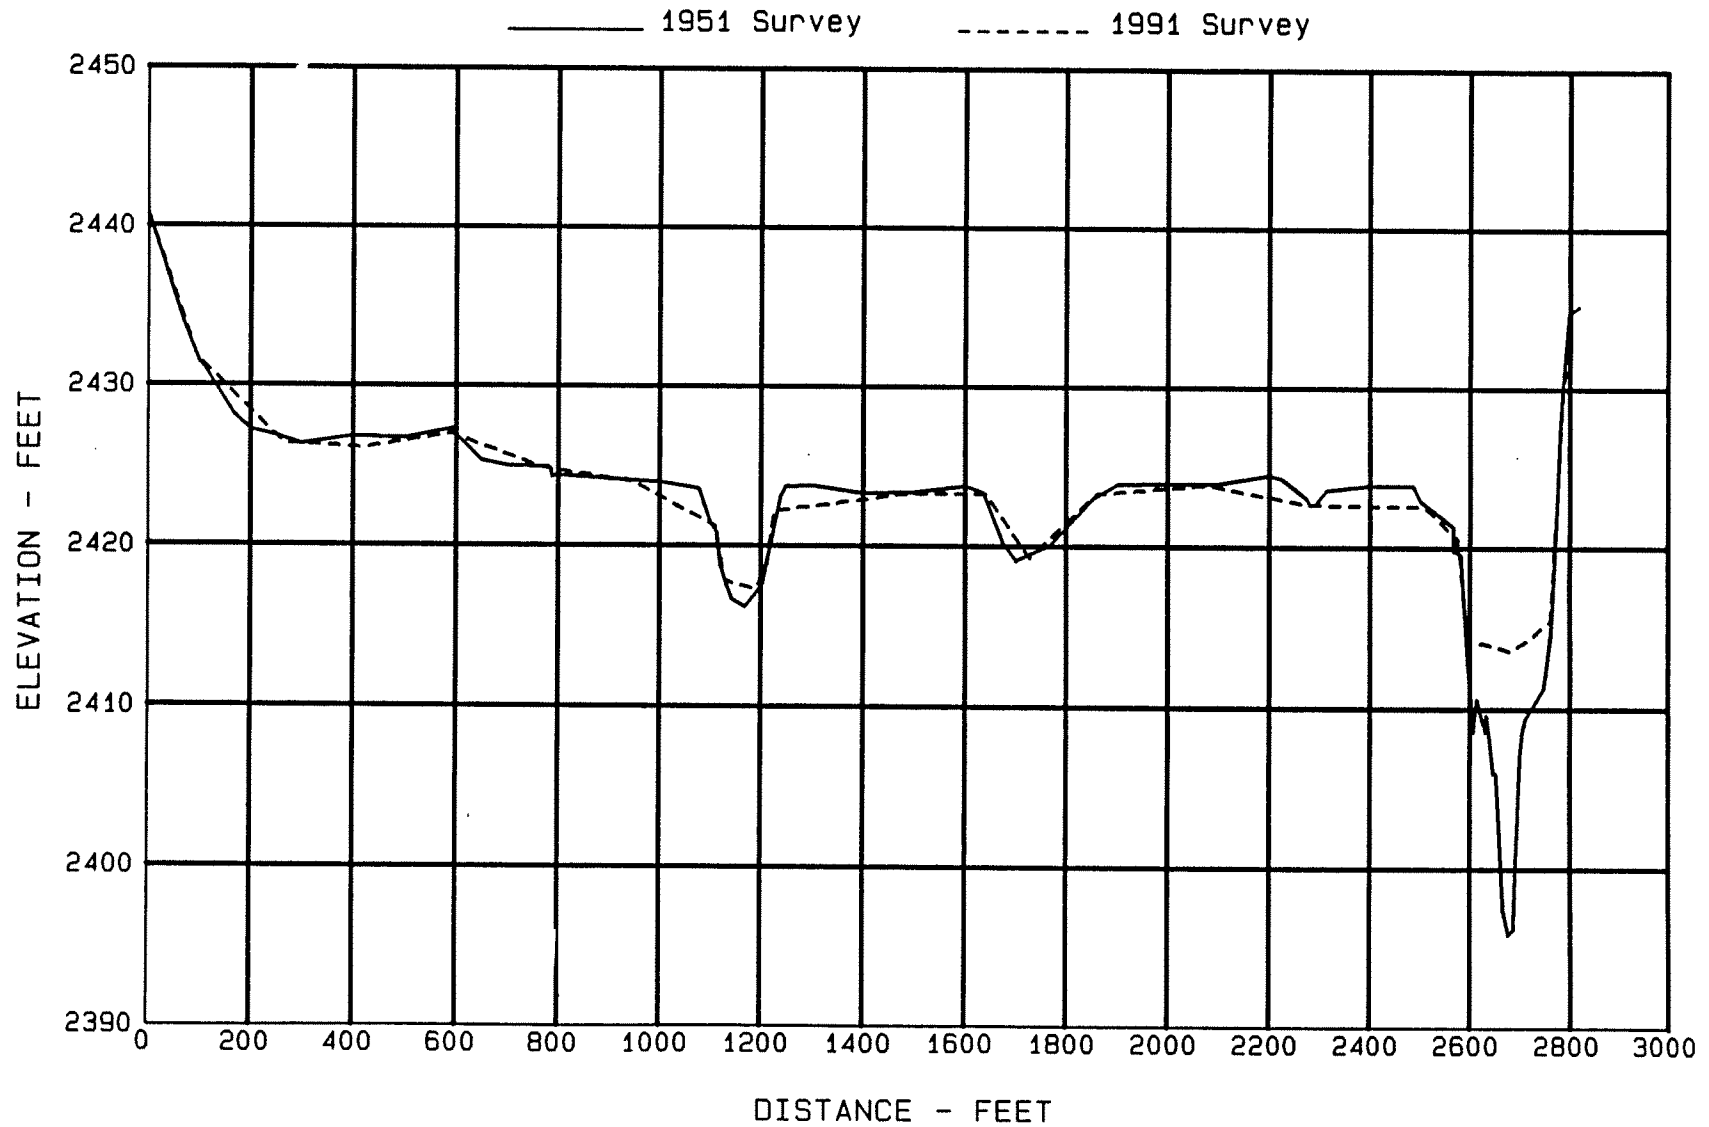


Figure 14. - Dickinson Dam ground profile for section R-10.

Dickinson Dam
GROUND PROFILE FOR SECTION R-11

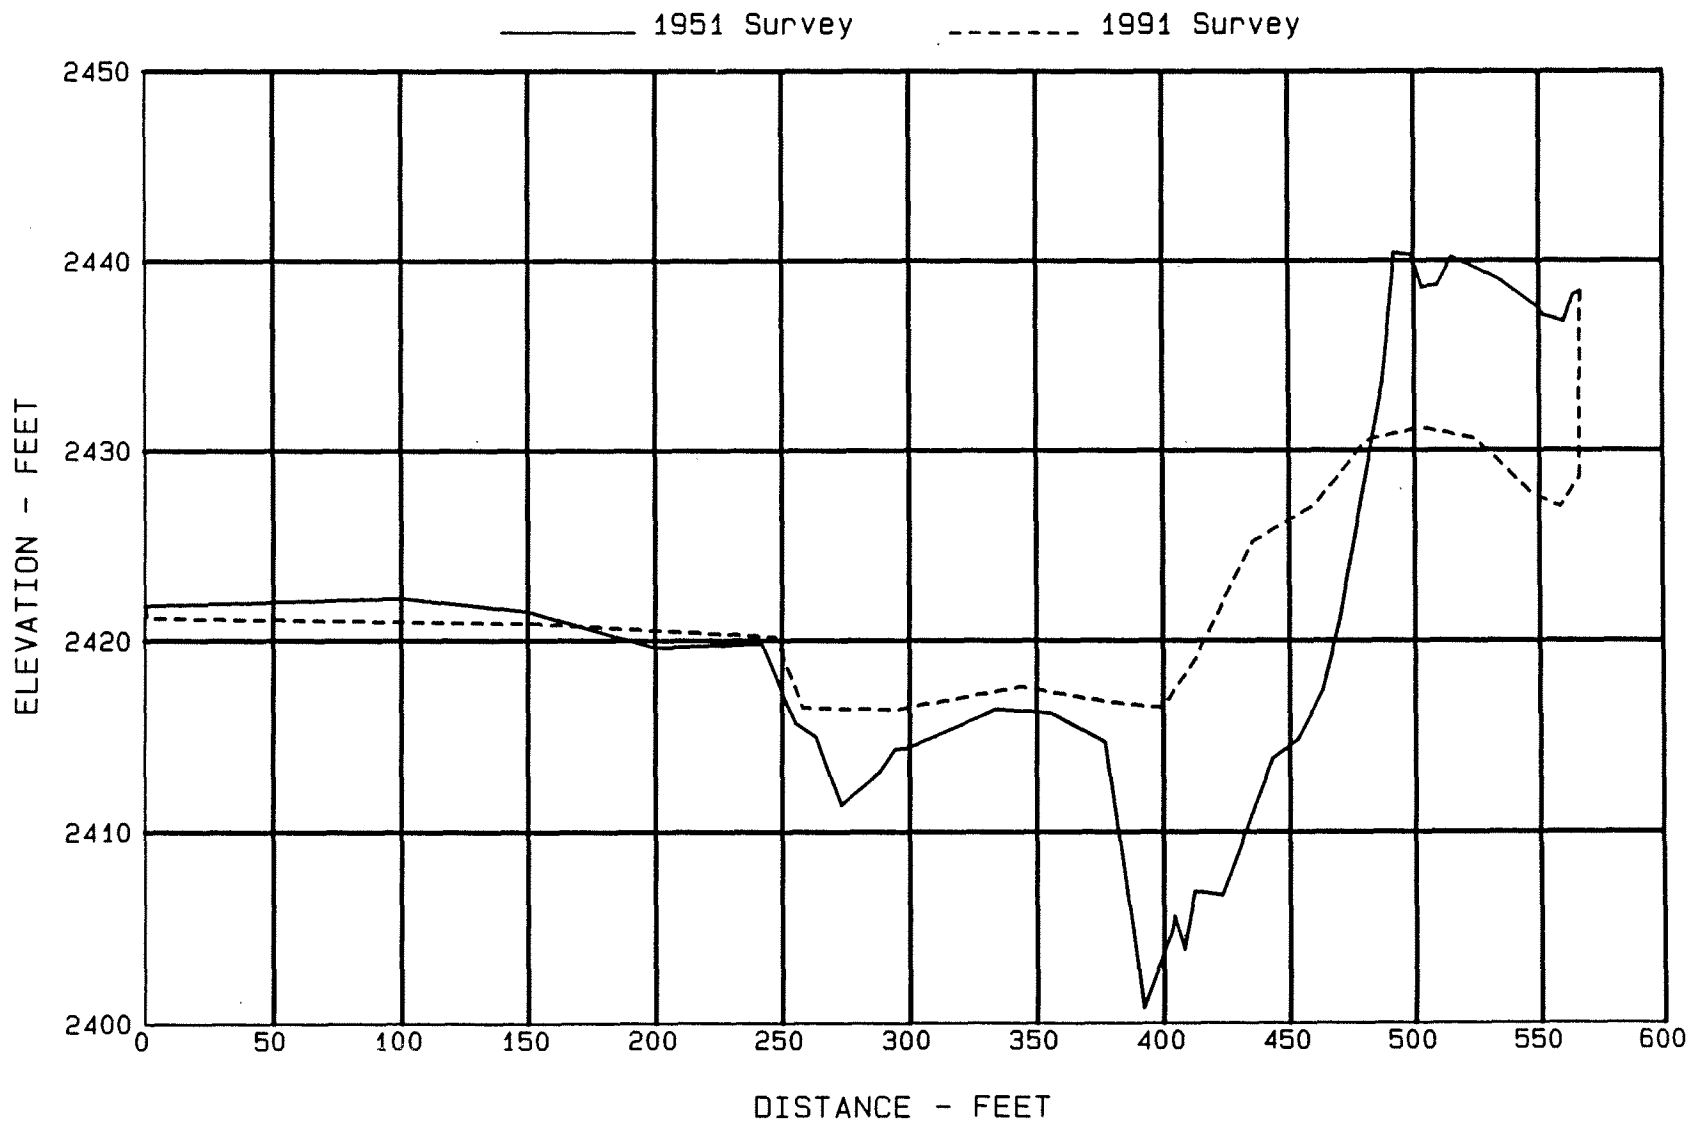


Figure 15. - Dickinson Dam ground profile for section R-11.

Dickinson Dam GROUND PROFILE FOR SECTION R-12

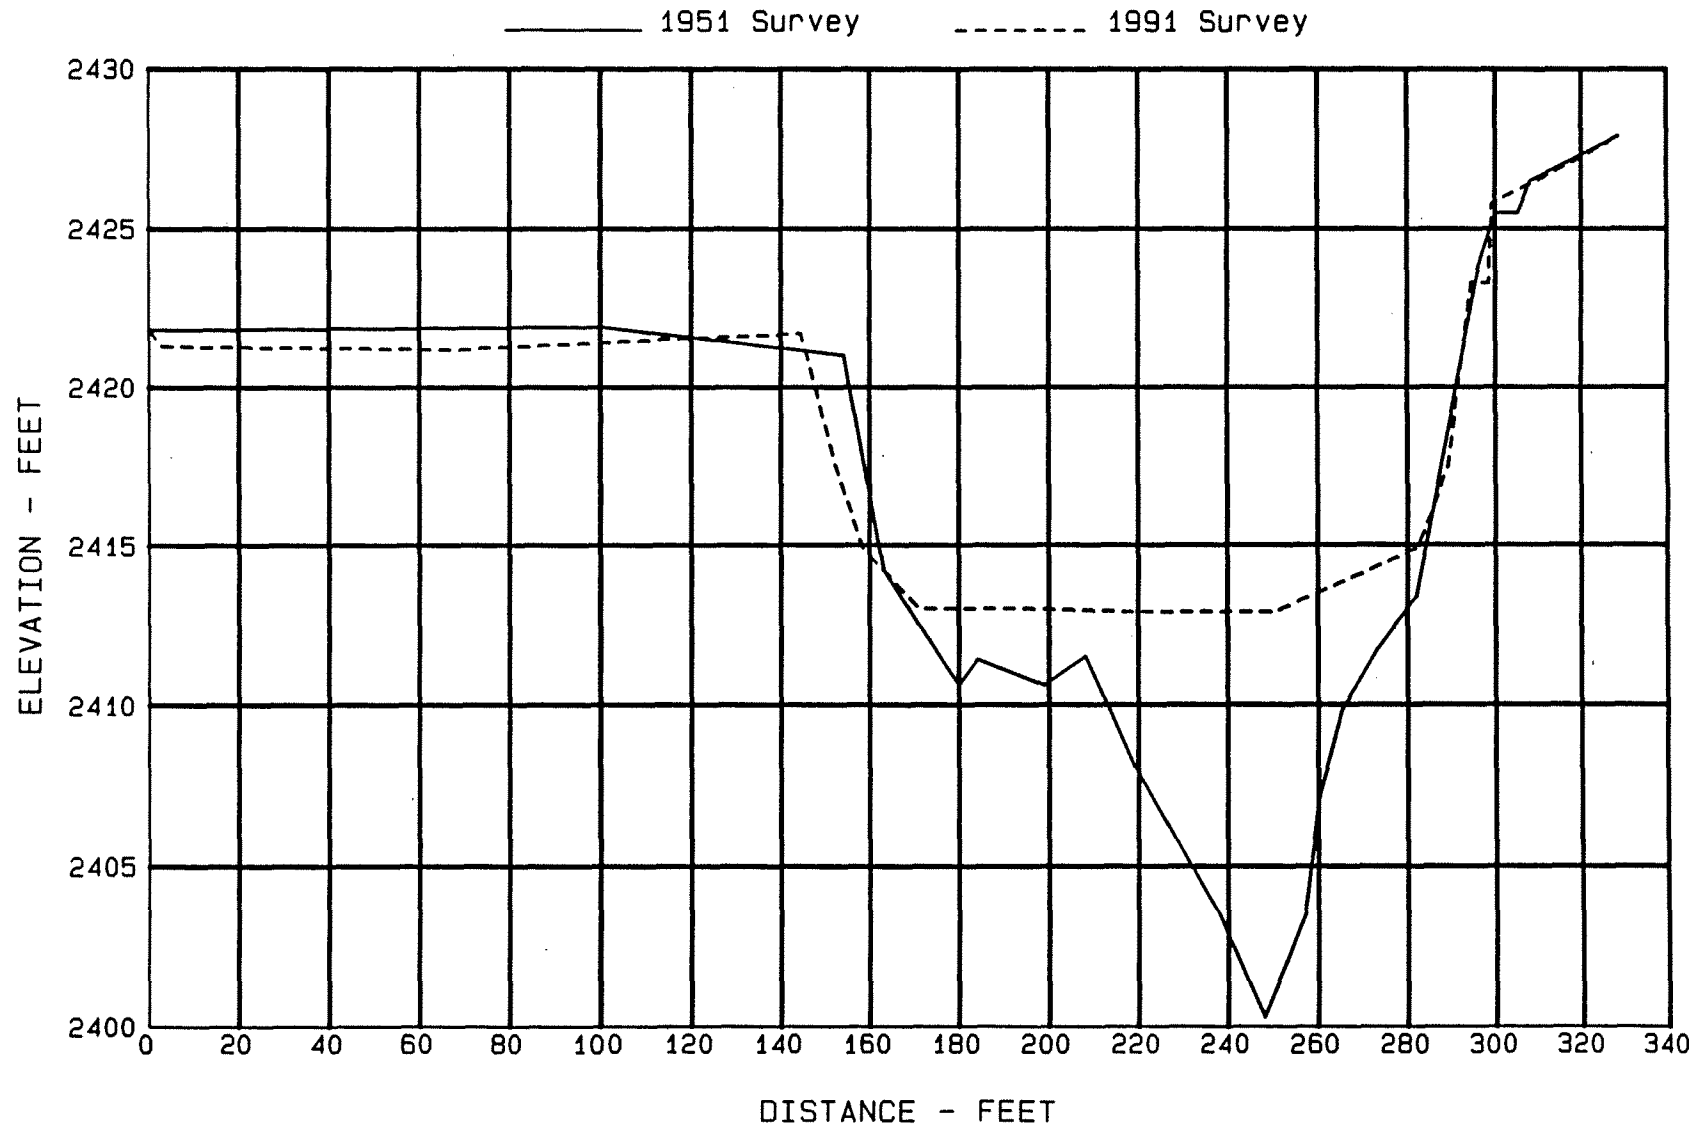


Figure 16. - Dickinson Dam ground profile for section R-12.

Dickinson Dam
GROUND PROFILE FOR SECTION R-13

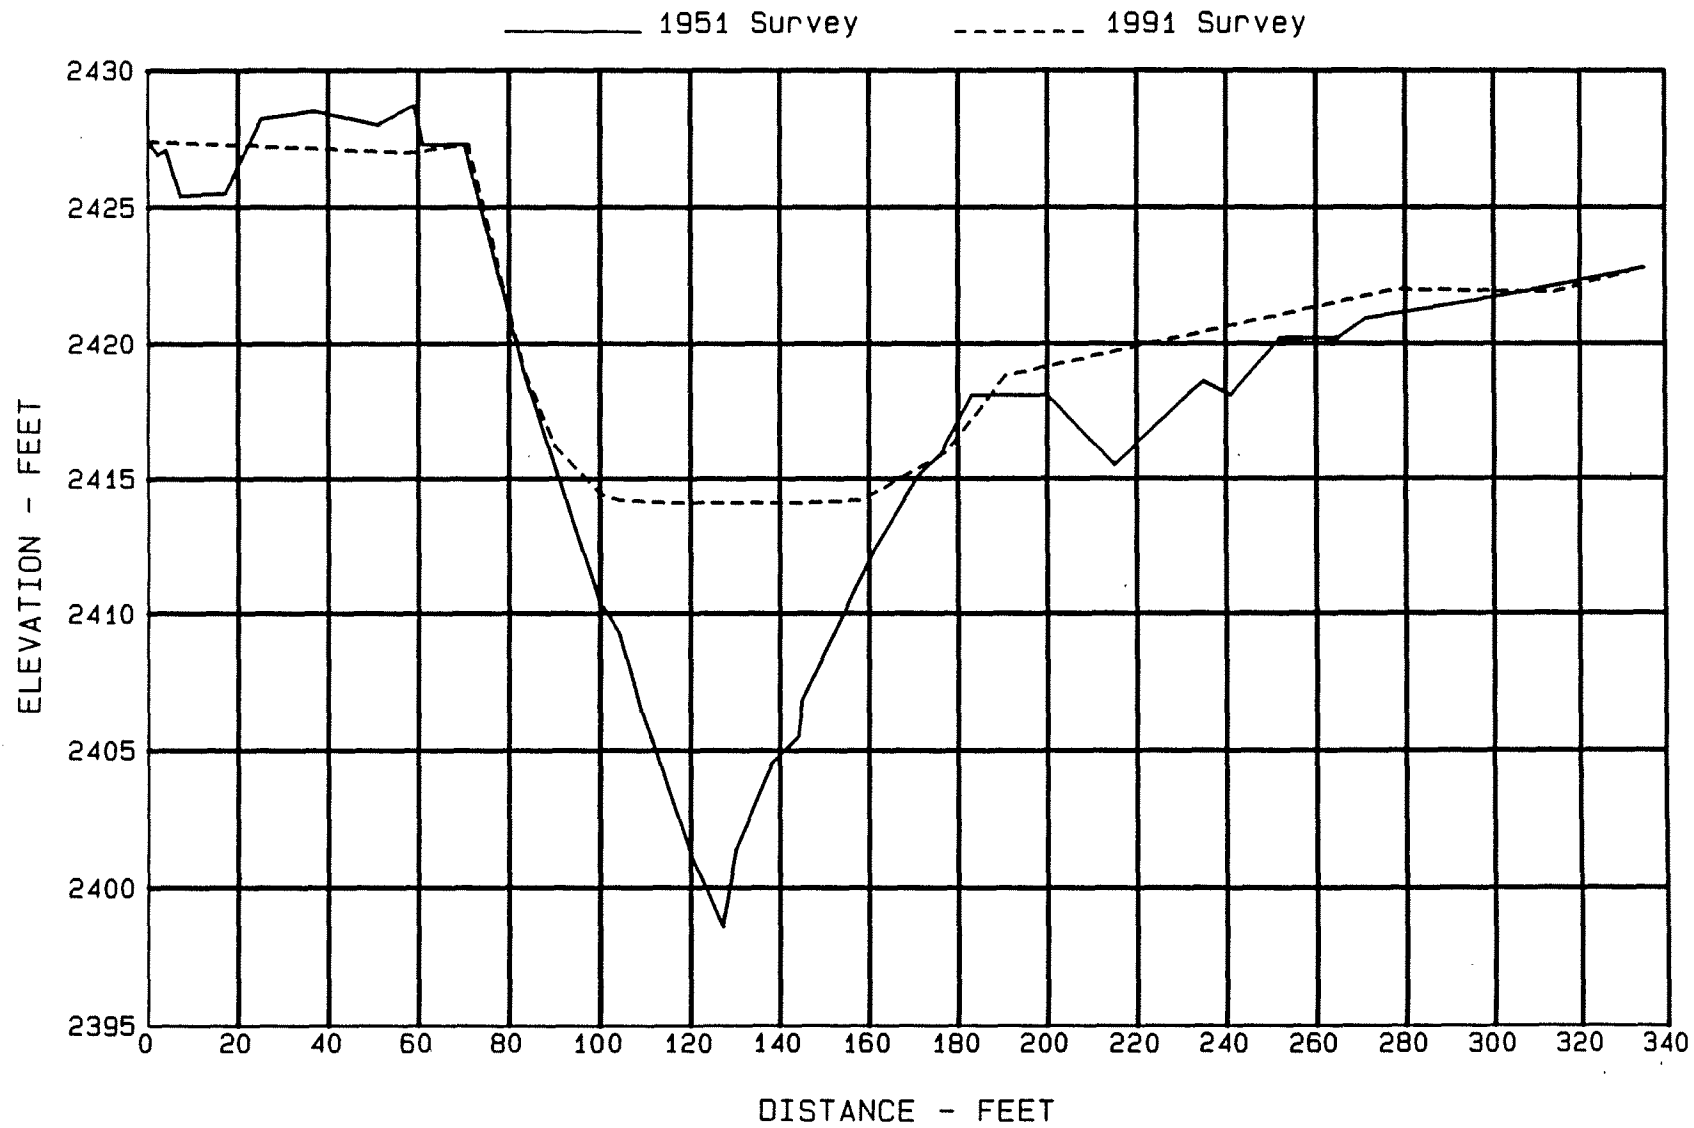


Figure 17. - Dickinson Dam ground profile for section R-13.

Dickinson Dam
GROUND PROFILE FOR SECTION R-14

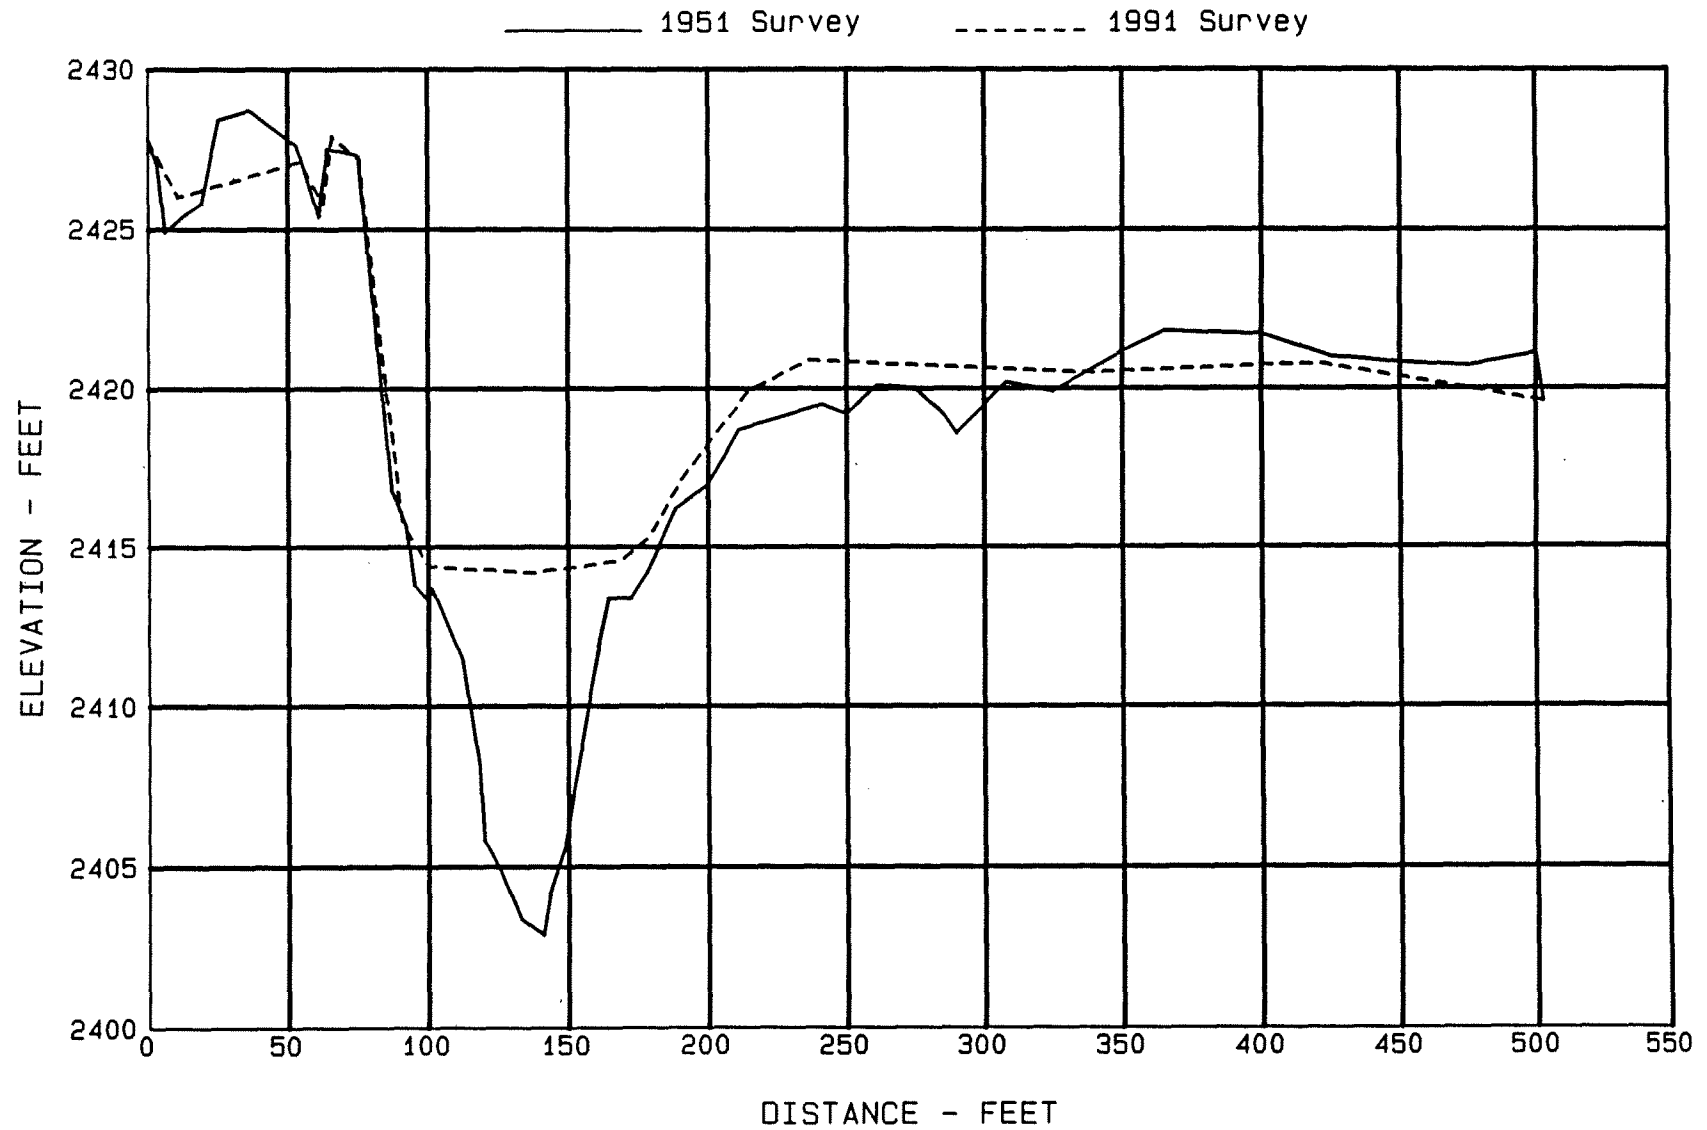


Figure 18. - Dickinson Dam ground profile for section R-14.

Dickinson Dam
GROUND PROFILE FOR SECTION R-15

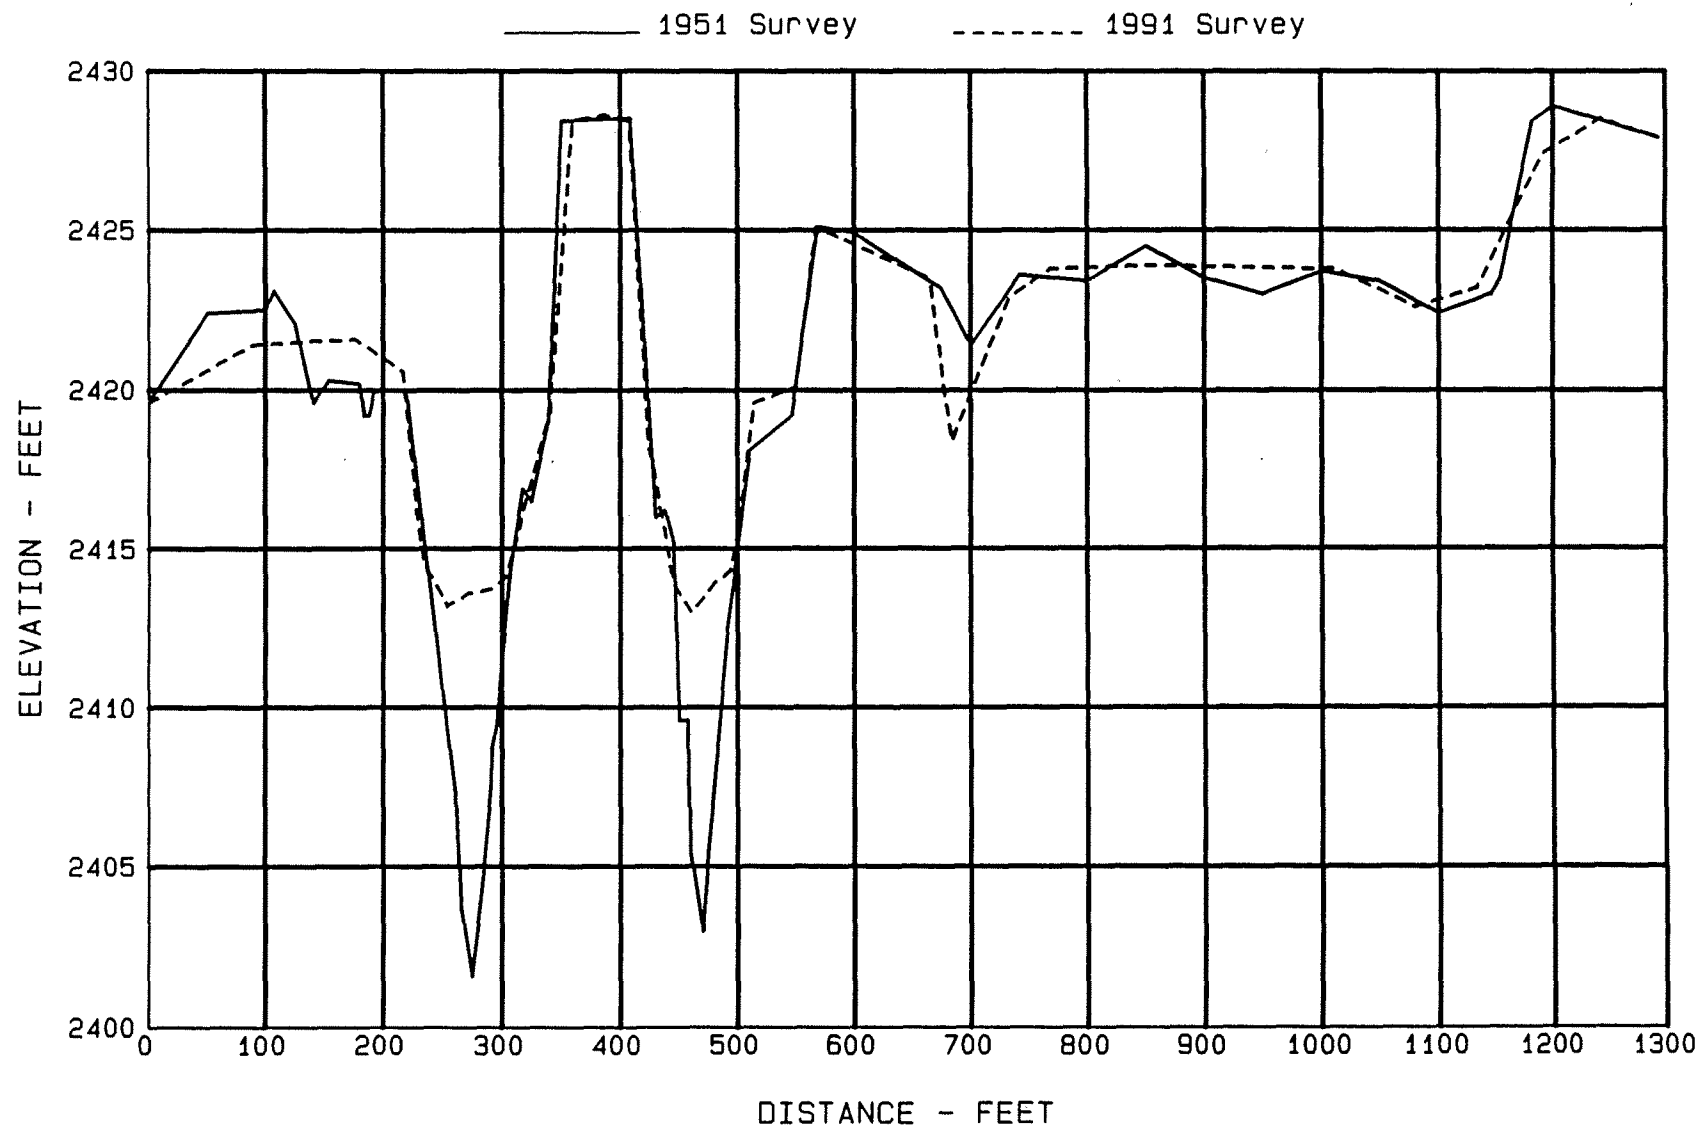


Figure 19. - Dickinson Dam ground profile for section R-15.

Dickinson Dam
GROUND PROFILE FOR SECTION R-16

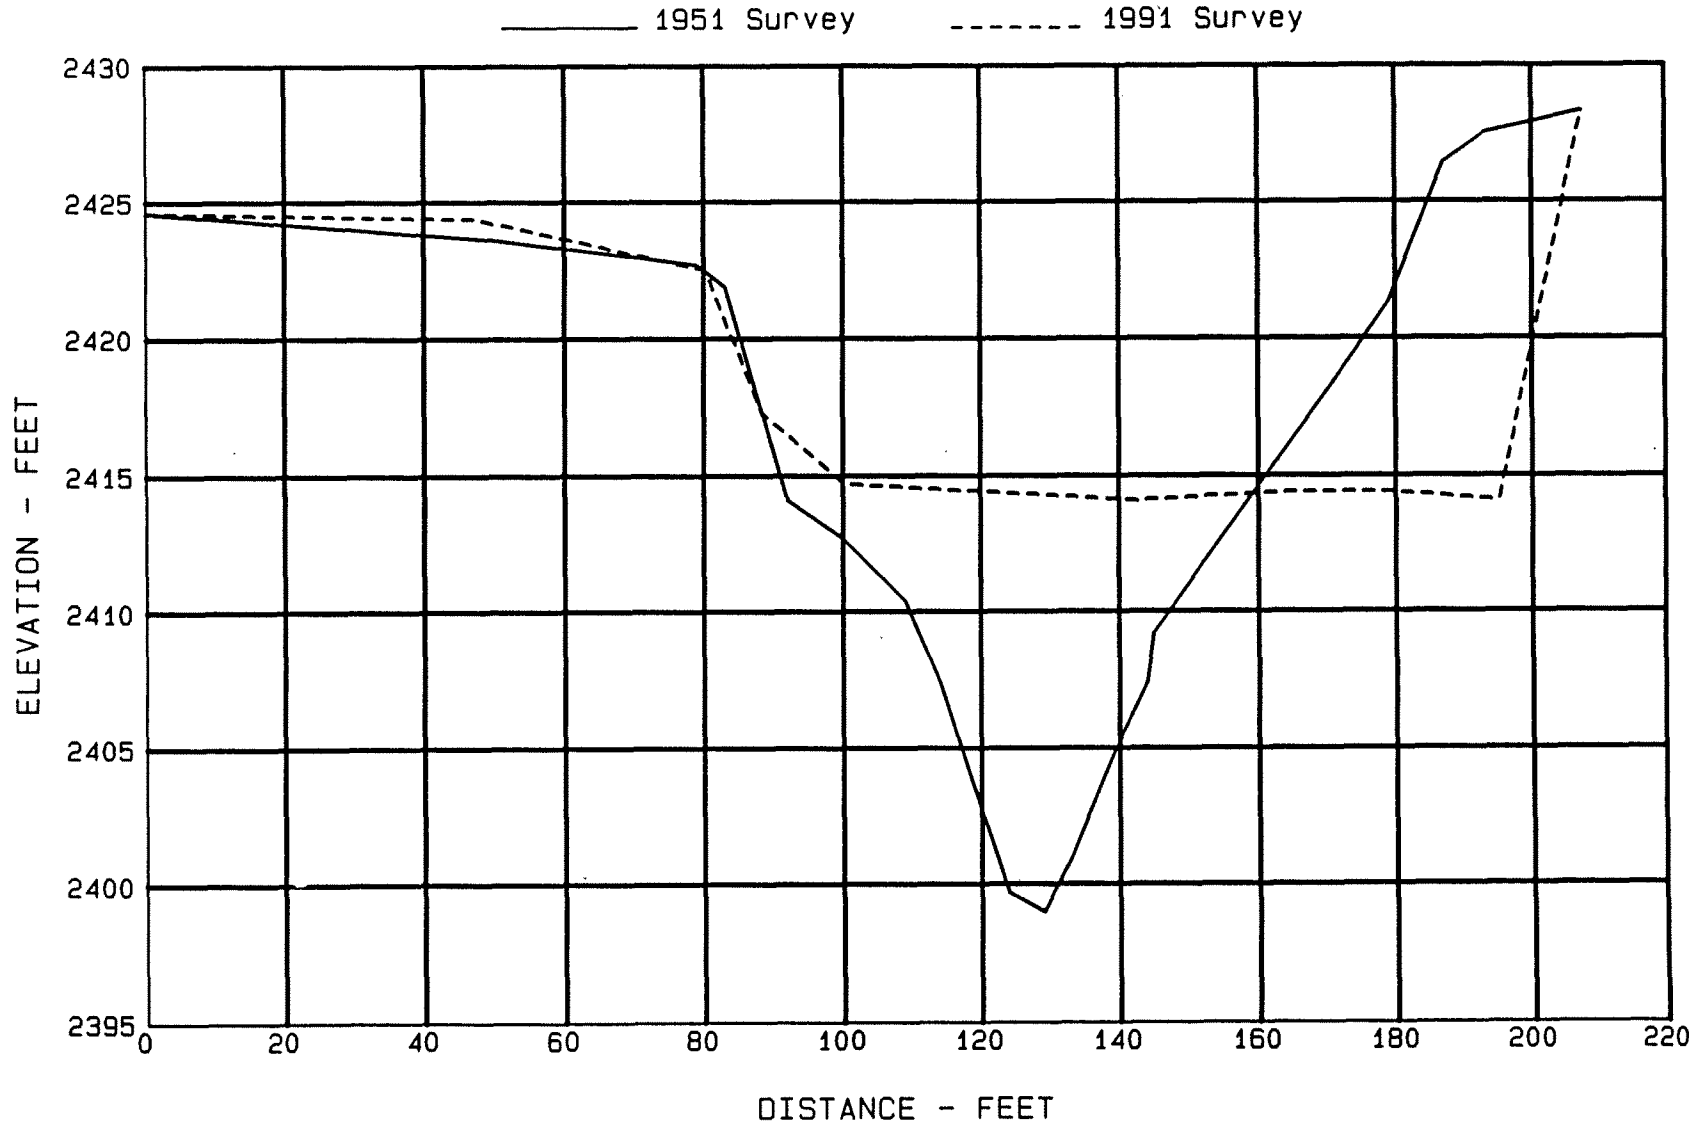


Figure 20. - Dickinson Dam ground profile for section R-16.

Dickinson Dam
GROUND PROFILE FOR SECTION R-17

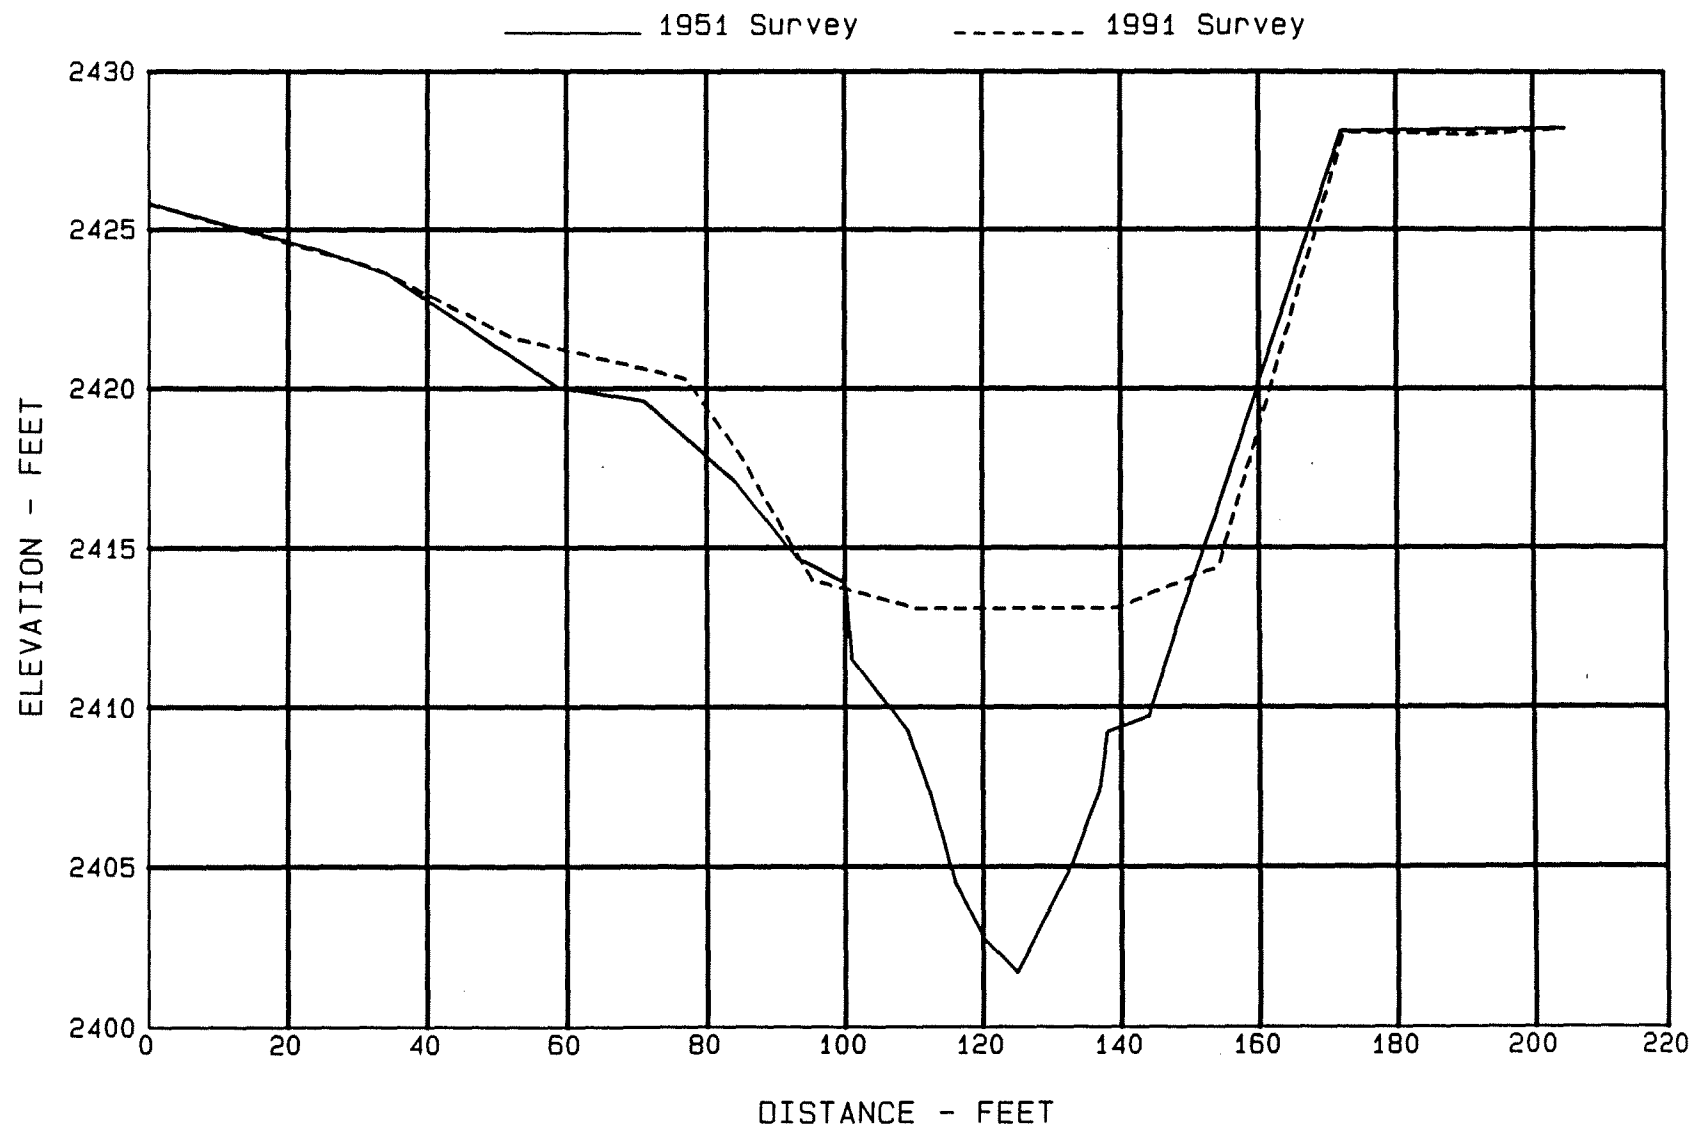


Figure 21. - Dickinson Dam ground profile for section R-17.

Dickinson Dam
GROUND PROFILE FOR SECTION R-18

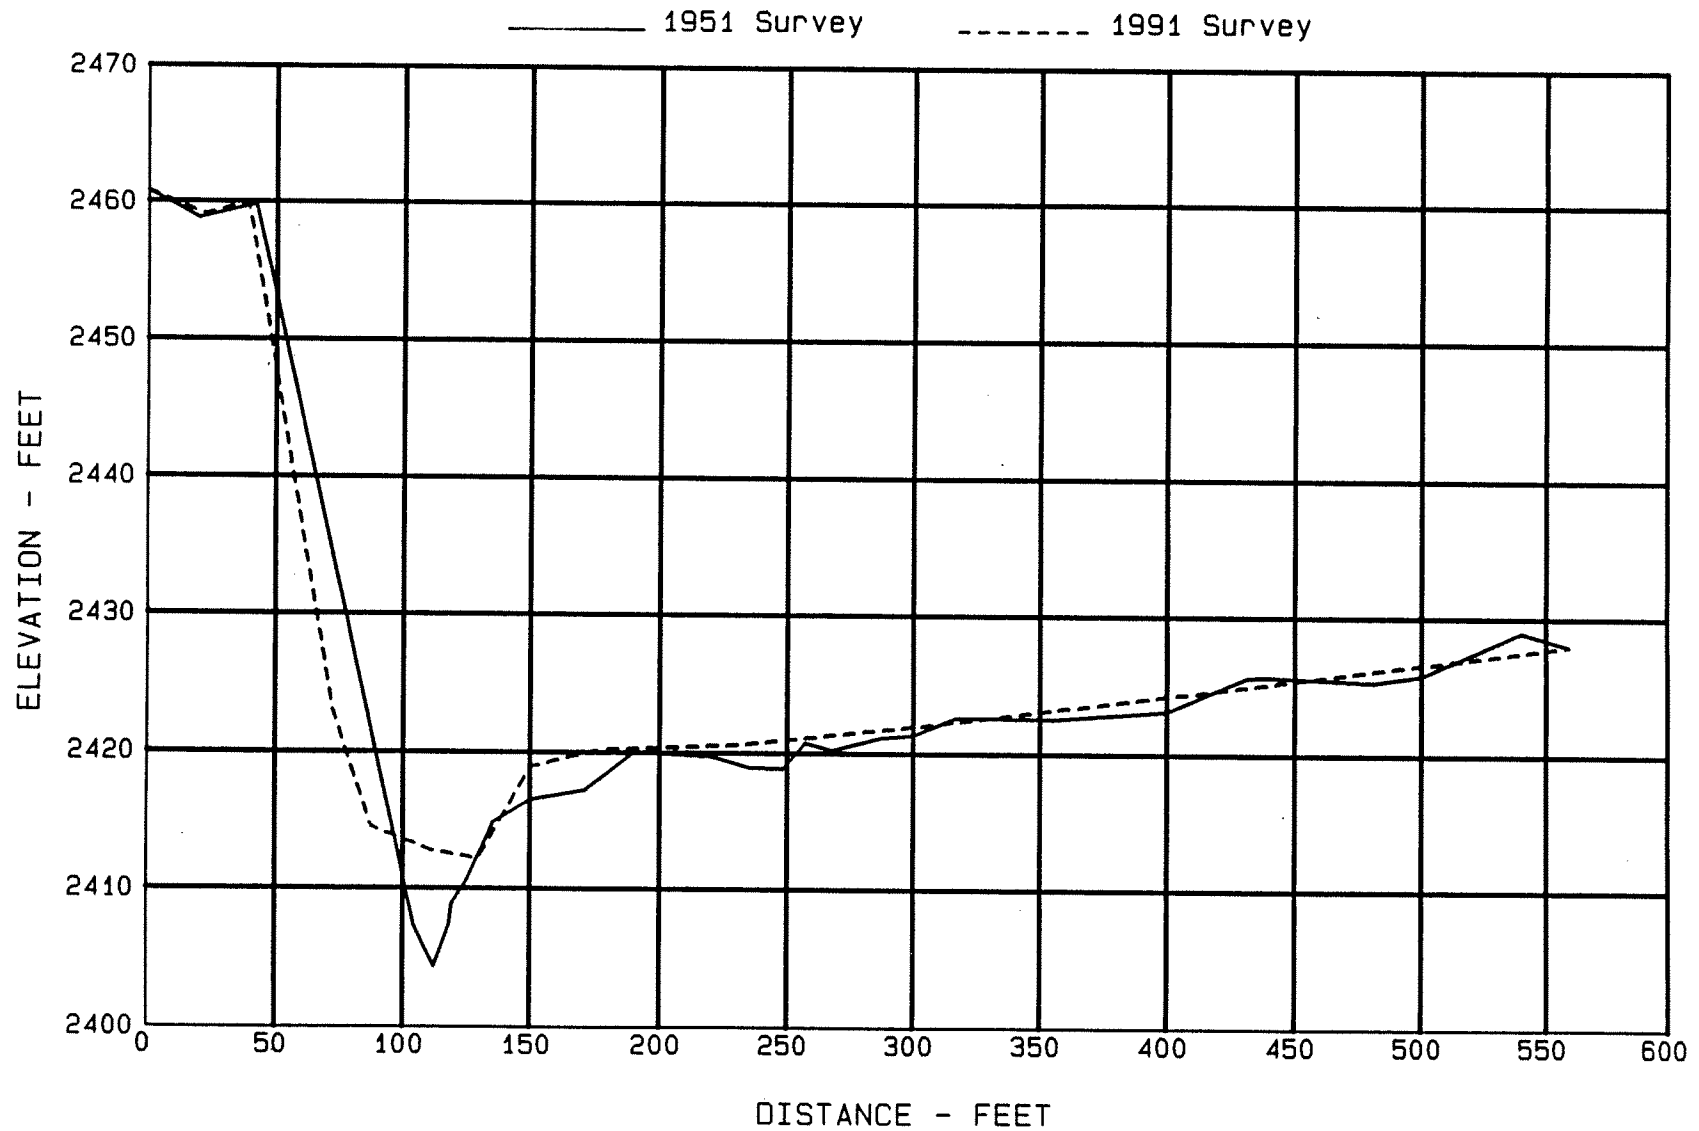


Figure 22. - Dickinson Dam ground profile for section R-18.

Dickinson Dam
GROUND PROFILE FOR SECTION R-19

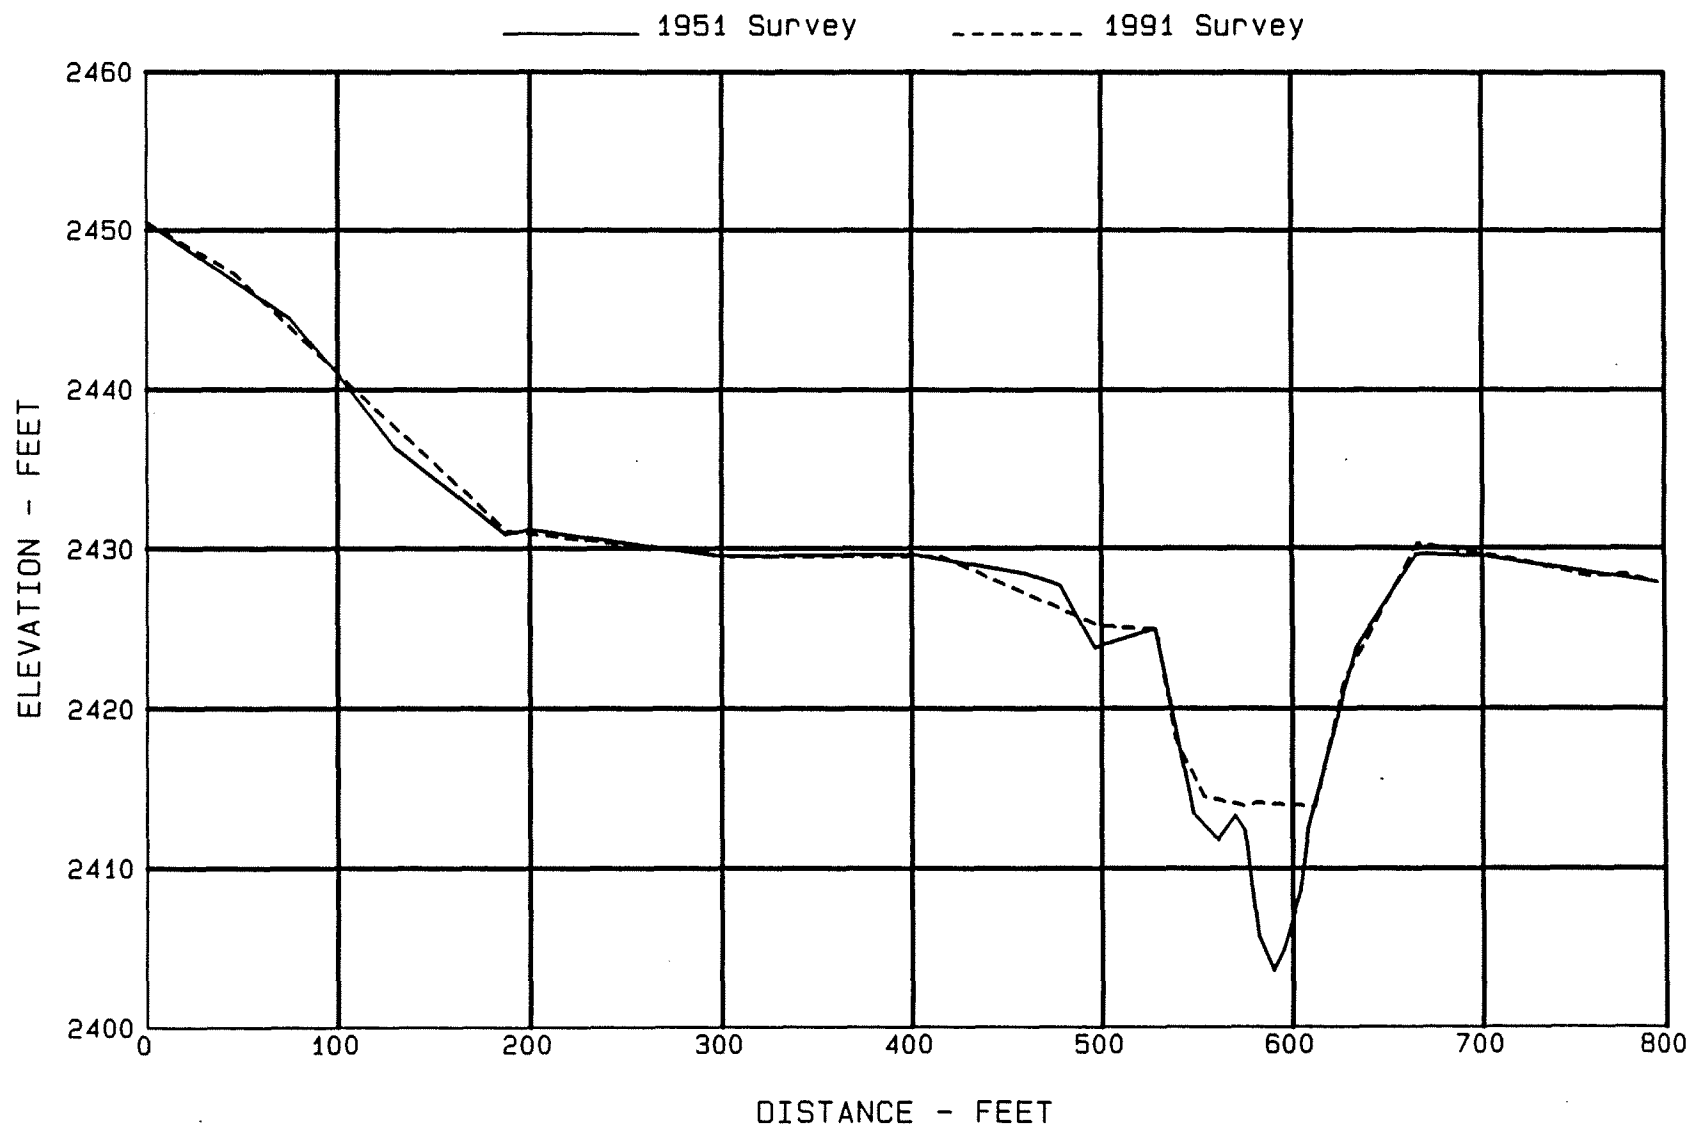


Figure 23. - Dickinson Dam ground profile for section R-19.

Dickinson Dam
GROUND PROFILE FOR SECTION R-20

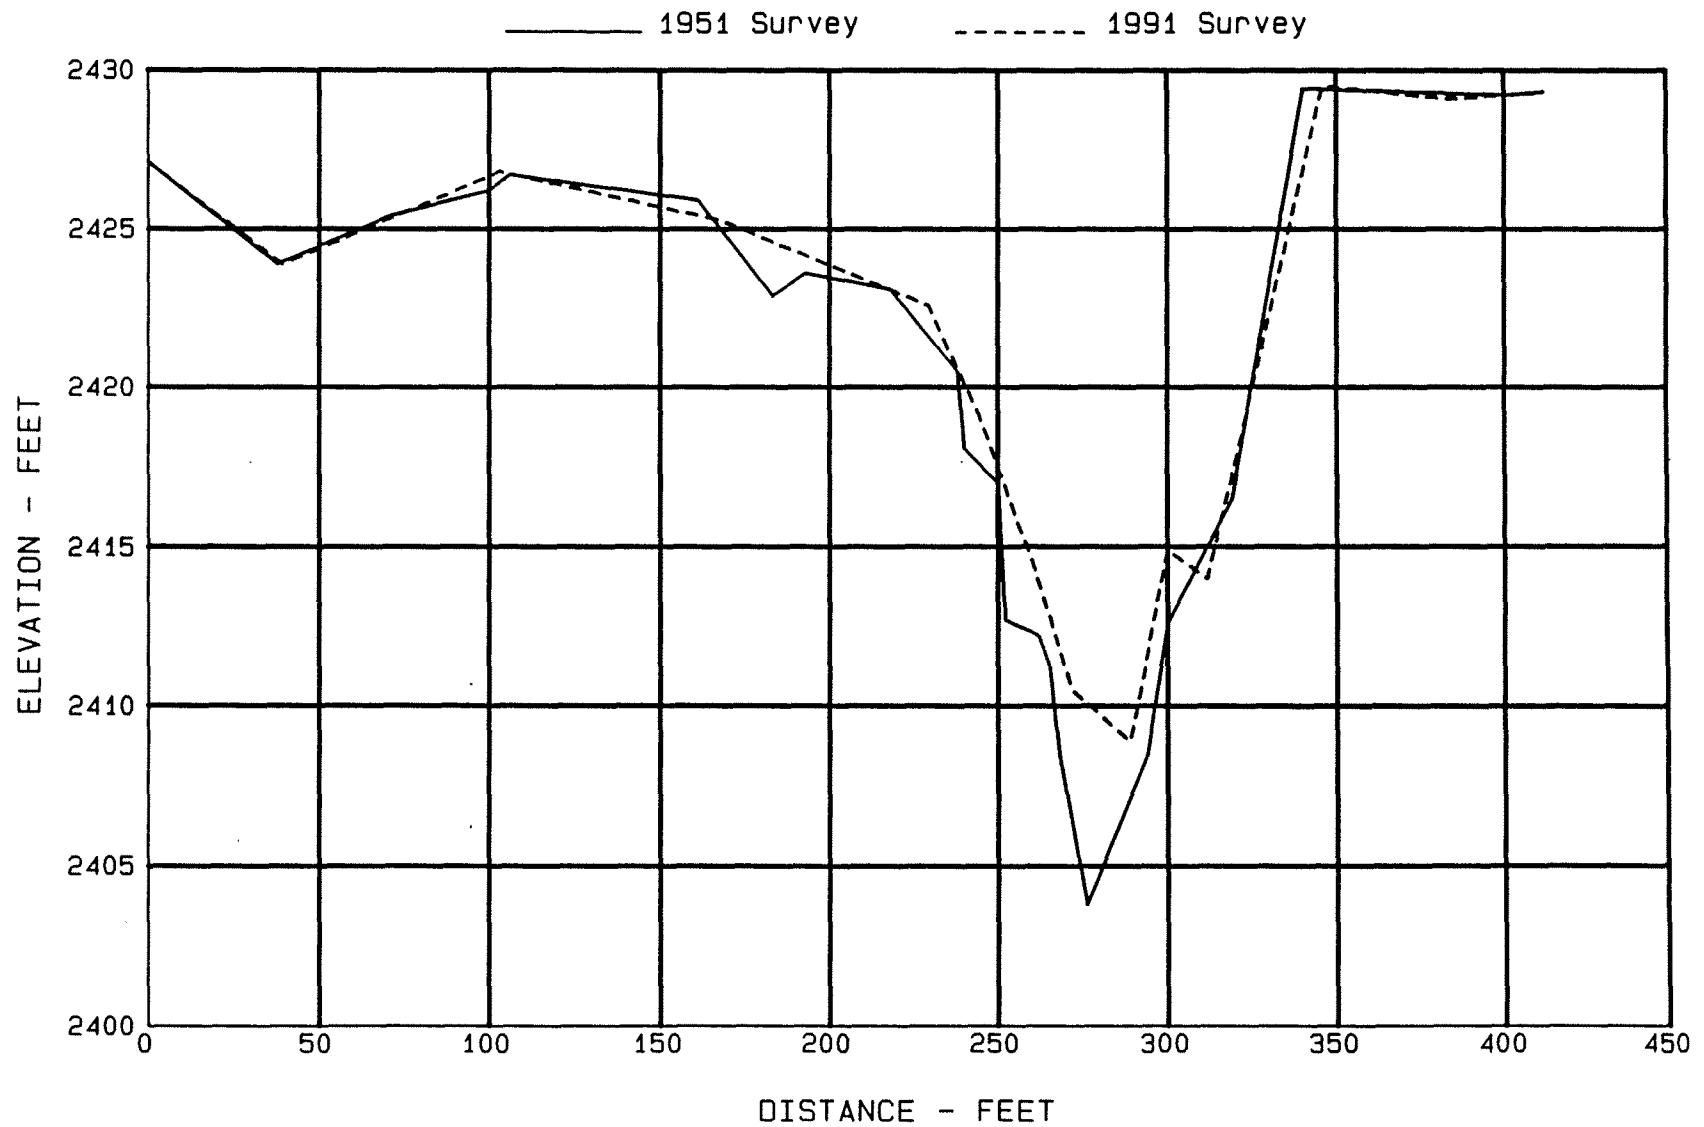


Figure 24. - Dickinson Dam ground profile for section R-20.

Dickinson Dam
GROUND PROFILE FOR SECTION R-21

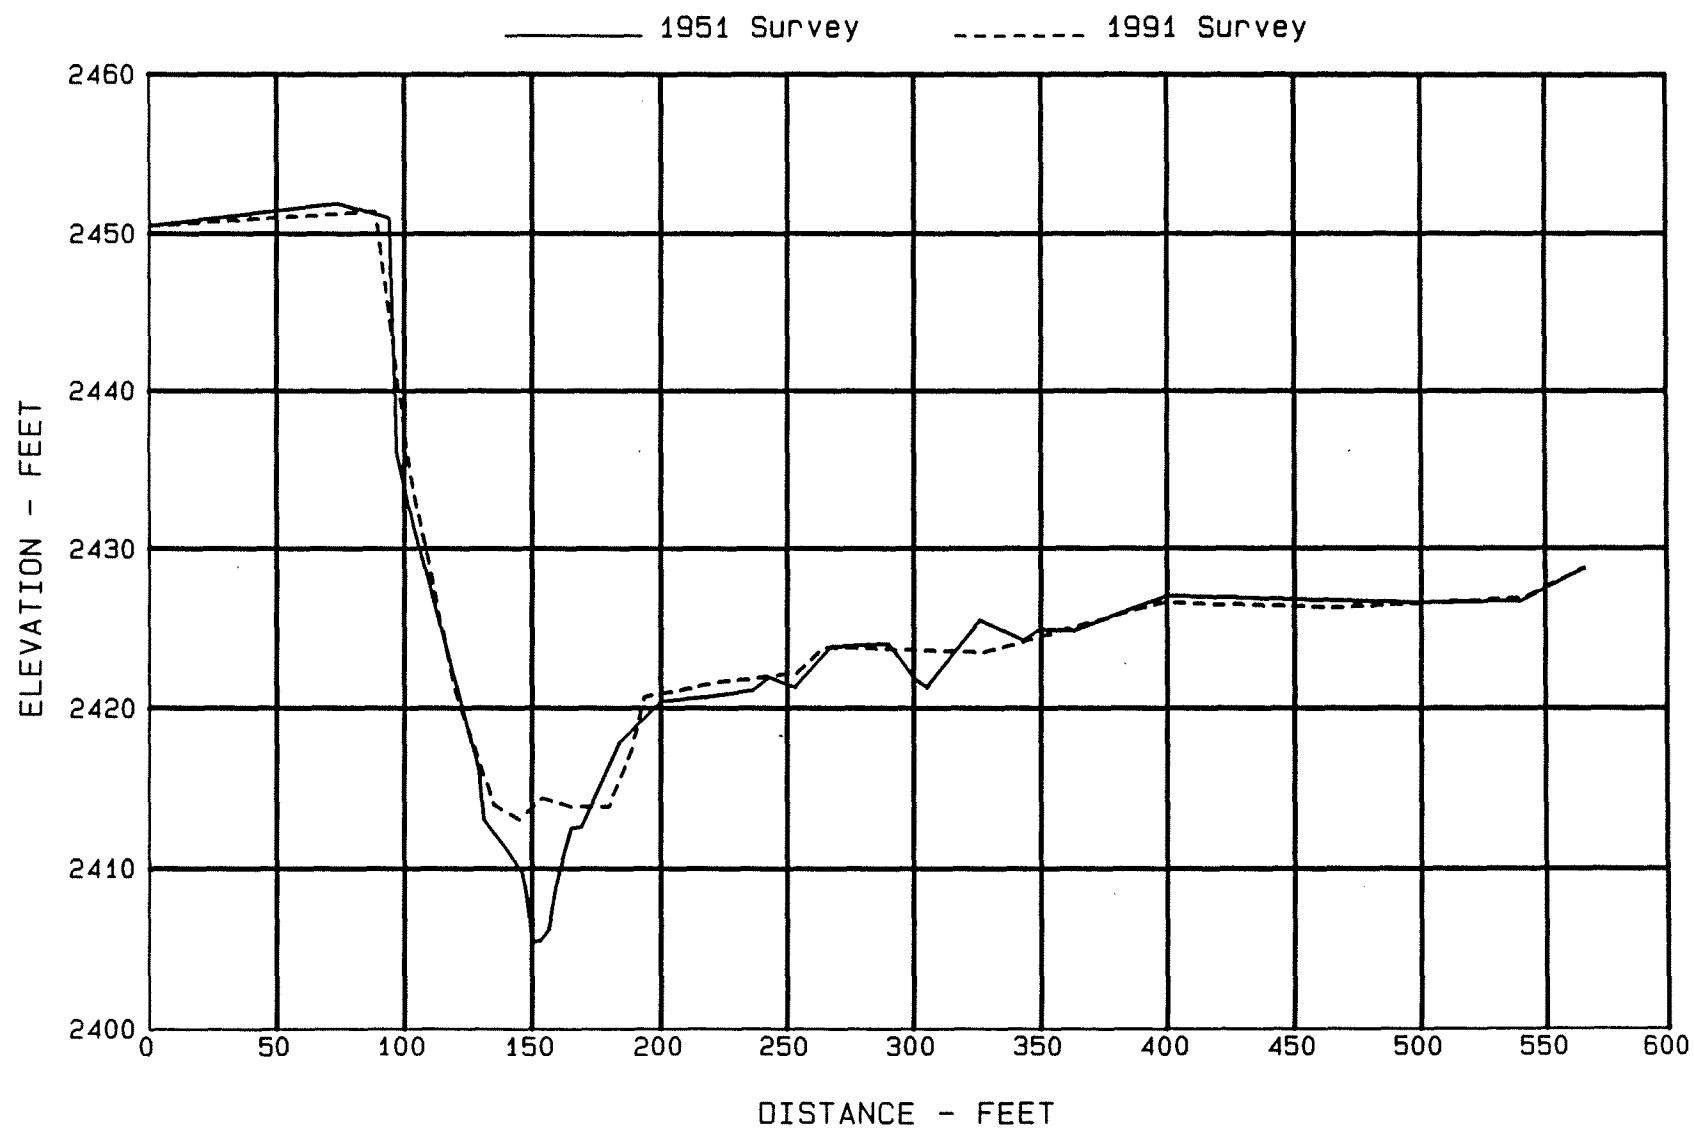


Figure 25. - Dickinson Dam ground profile for section R-21.

Dickinson Dam
GROUND PROFILE FOR SECTION R-22

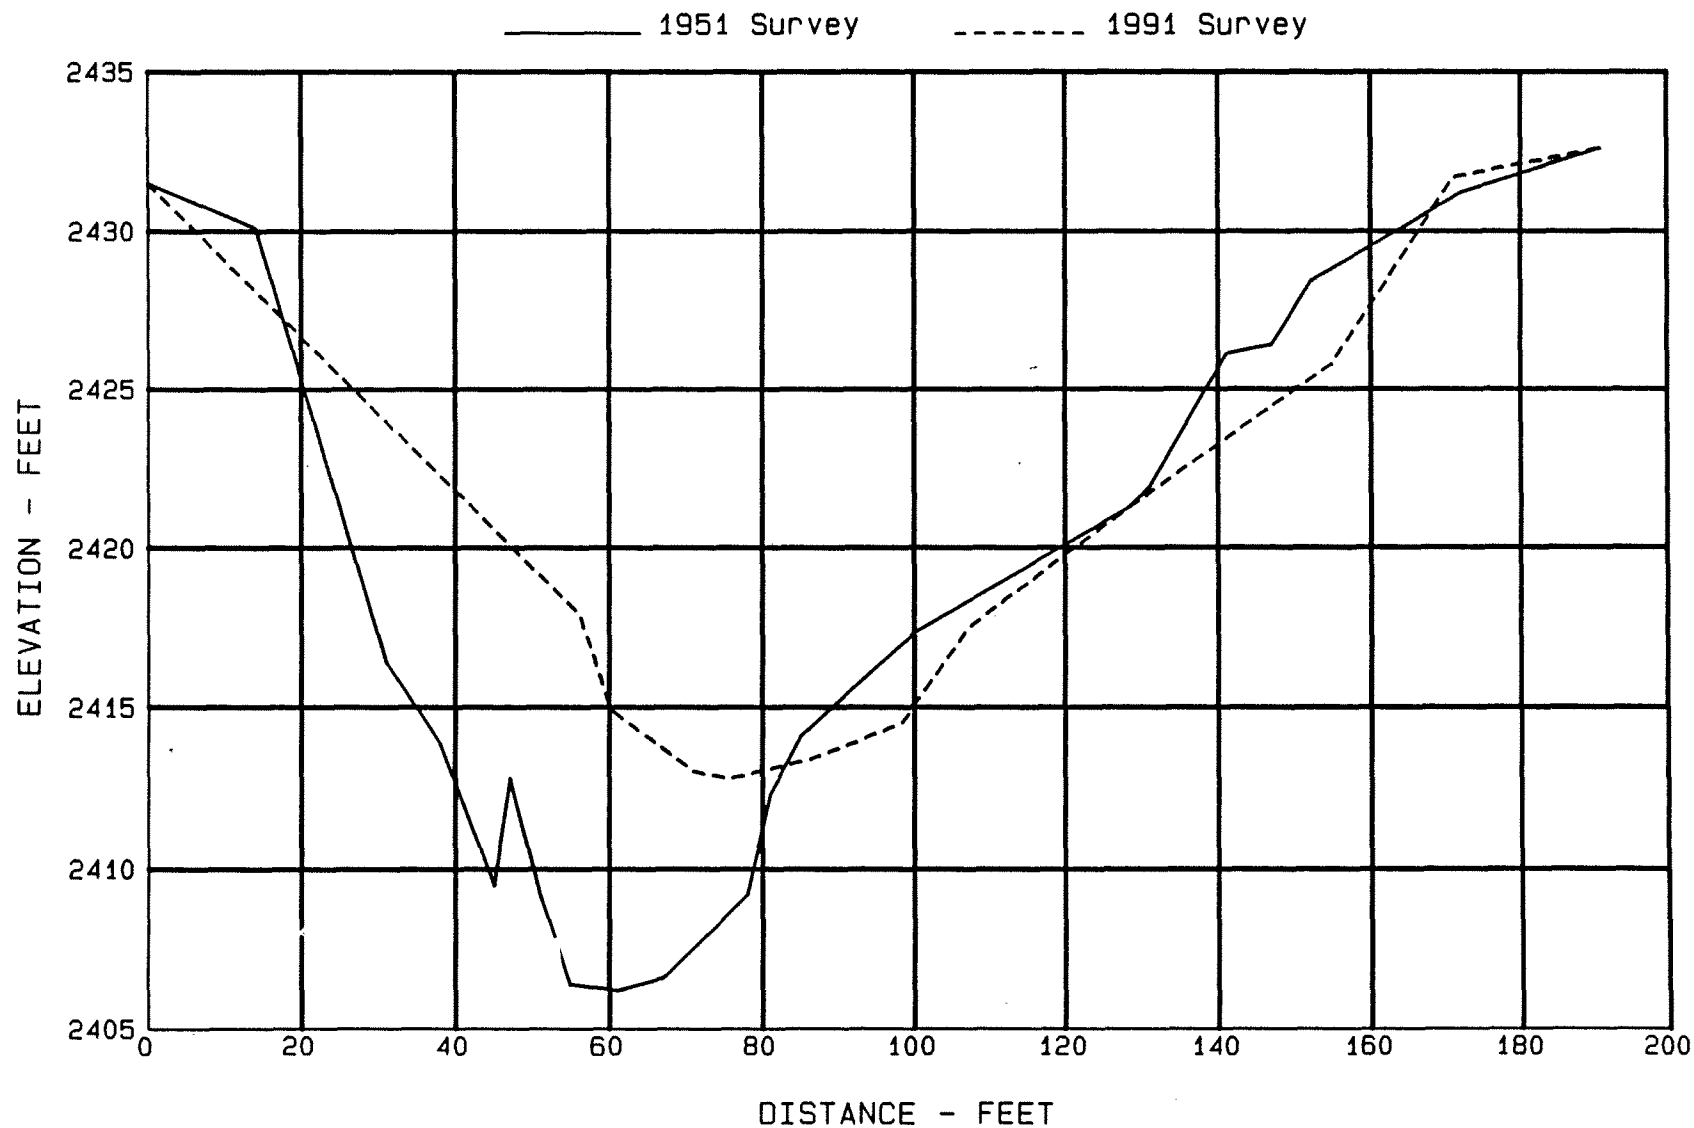


Figure 26. - Dickinson Dam ground profile for section R-22.

Dickinson Dam
GROUND PROFILE FOR SECTION R-23

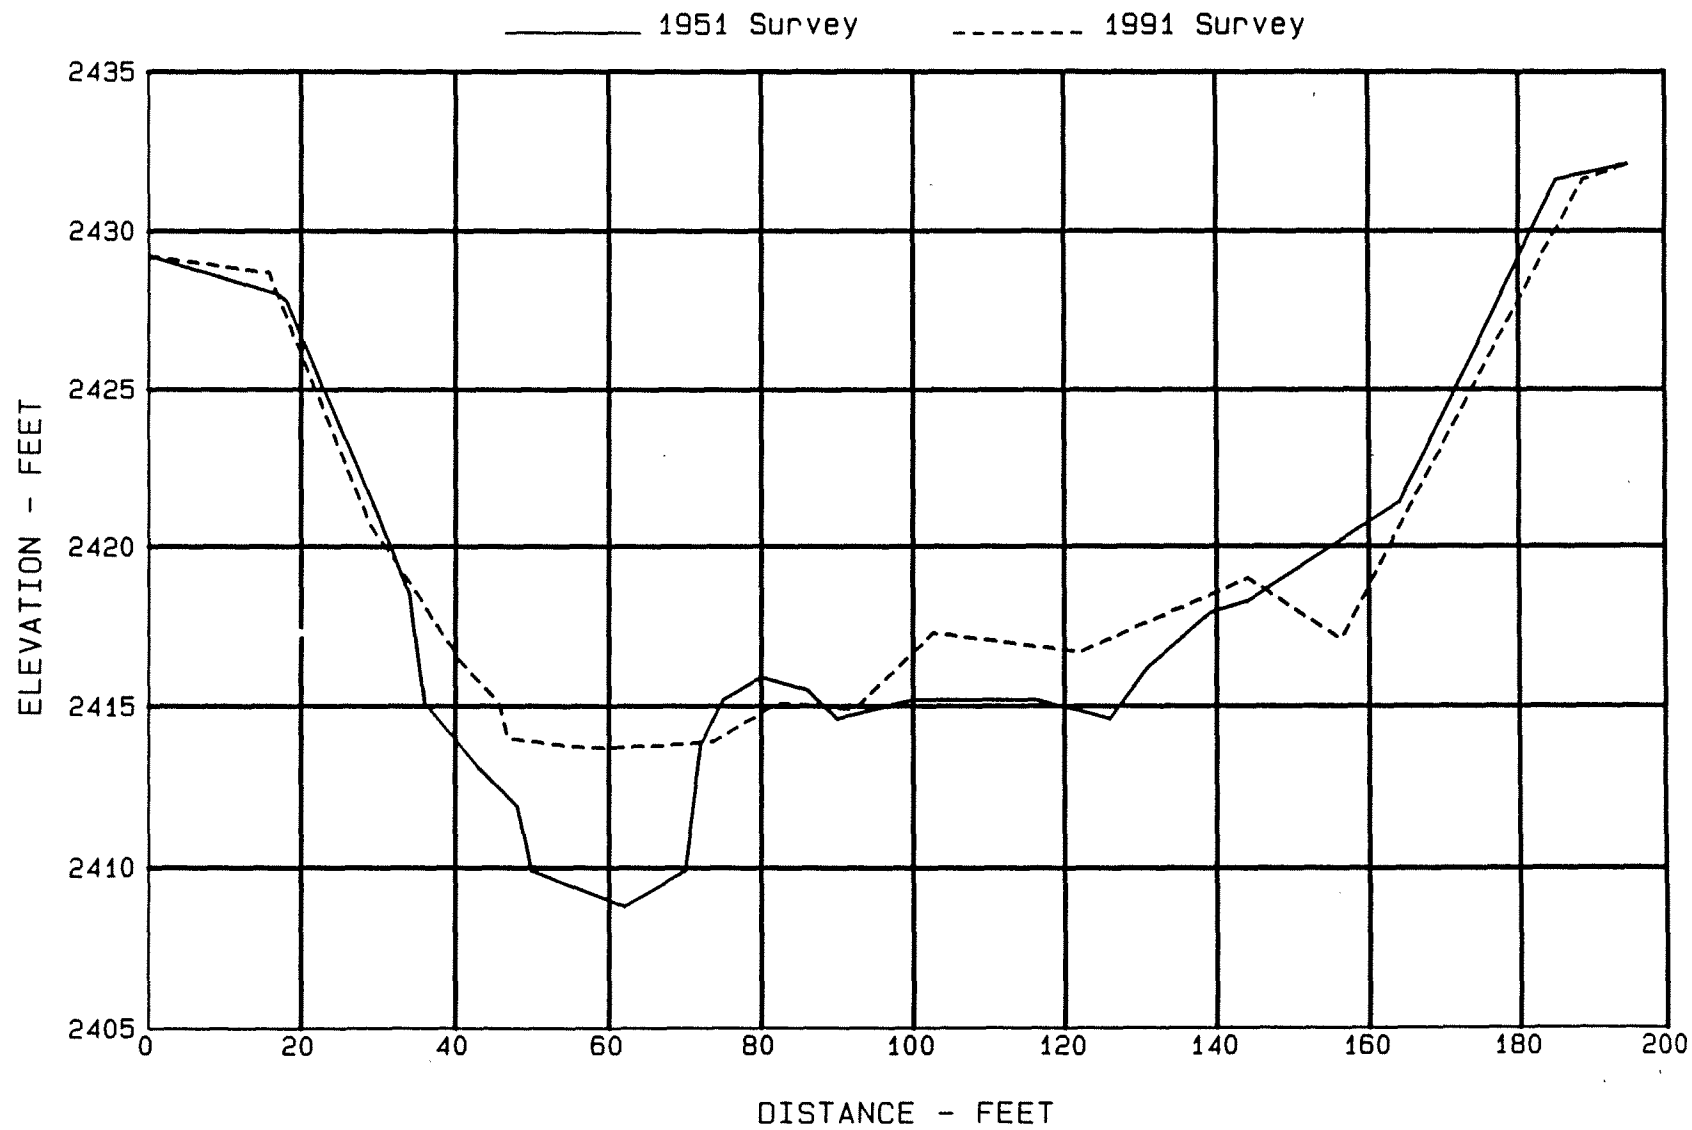


Figure 27. - Dickinson Dam ground profile for section R-23.

Dickinson Dam
GROUND PROFILE FOR SECTION R-24

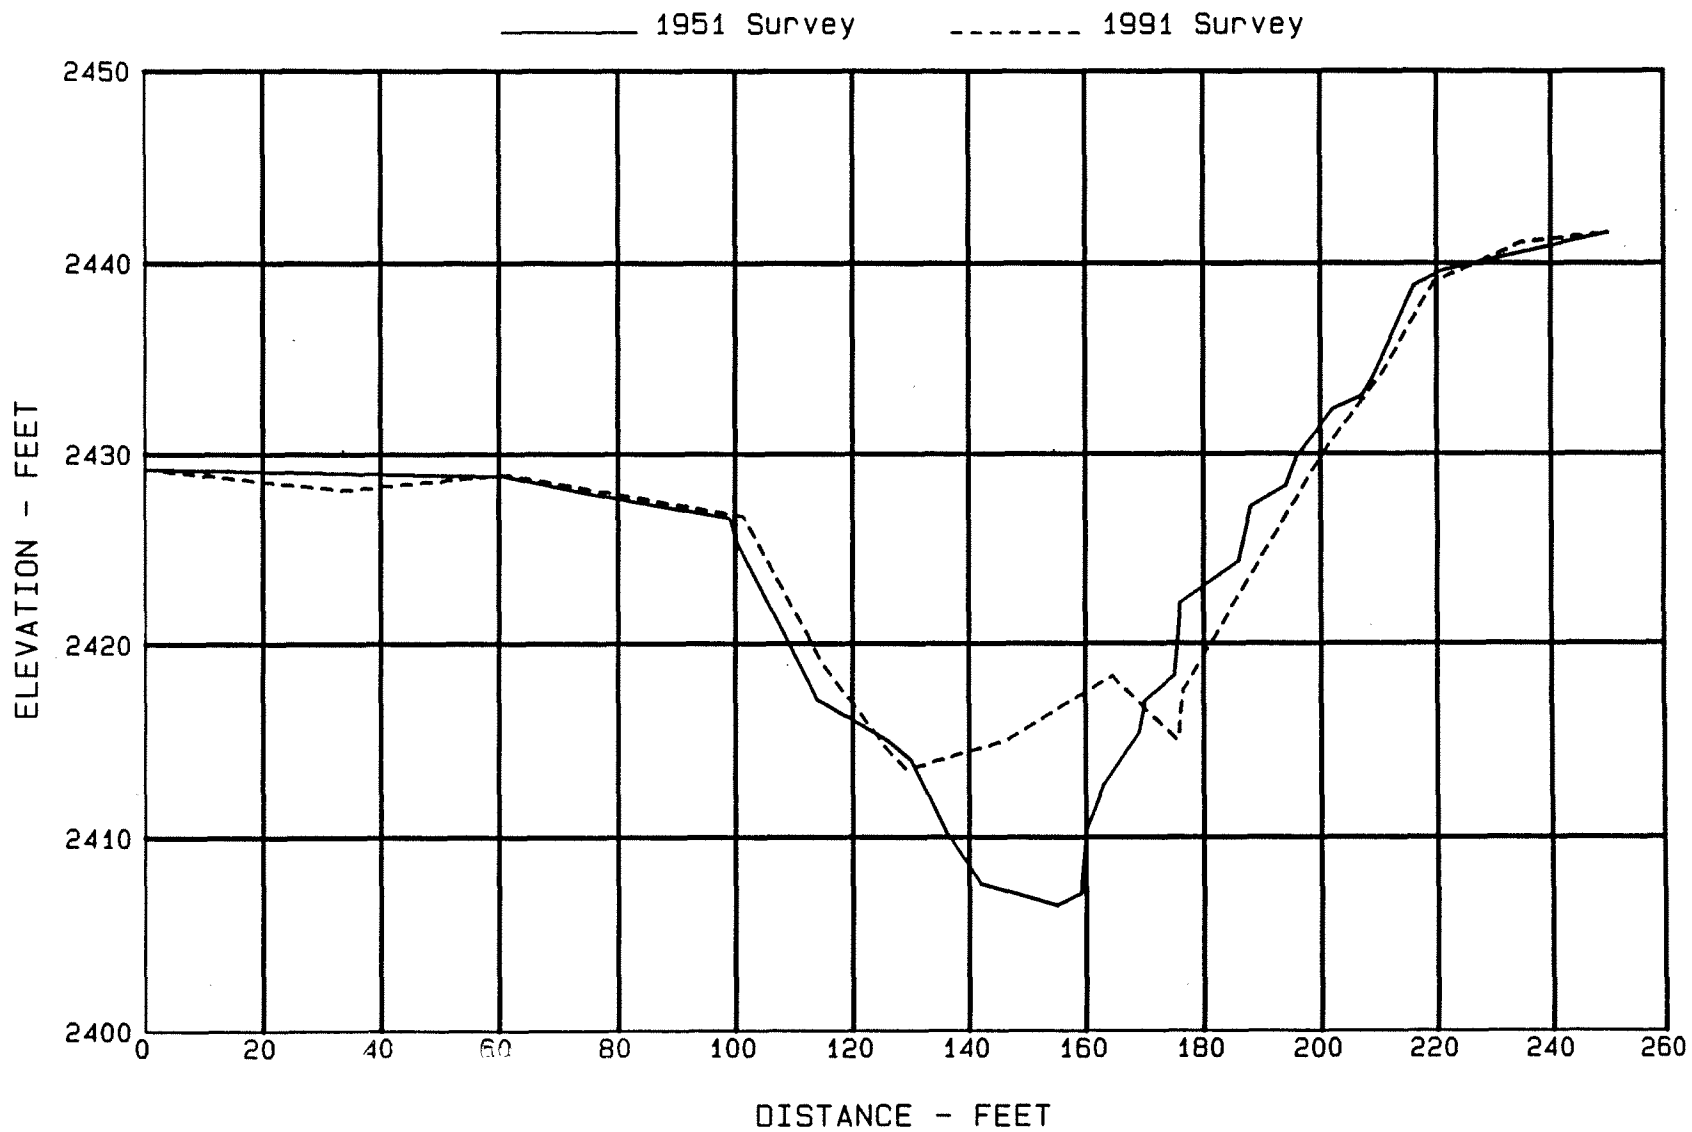


Figure 28. - Dickinson Dam ground profile for section R-24.

Dickinson Dam
GROUND PROFILE FOR SECTION R-25

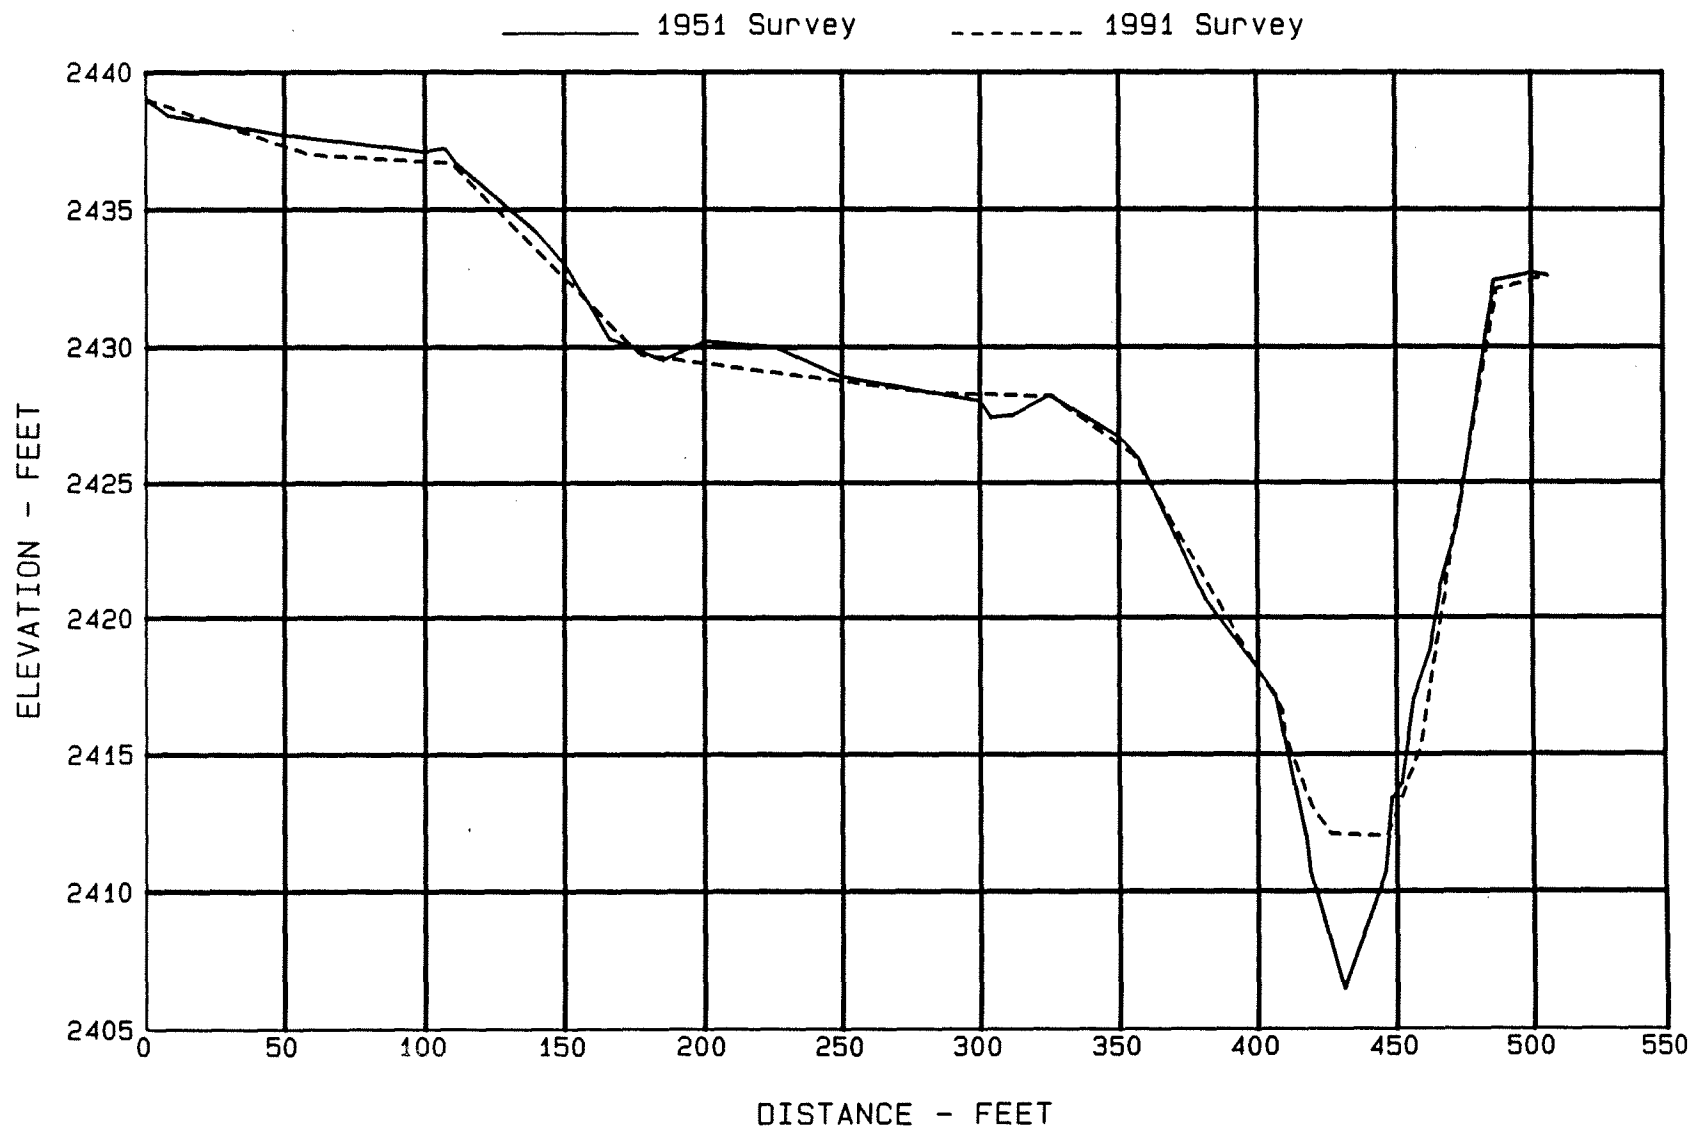


Figure 29. - Dickinson Dam ground profile for section R-25.

Dickinson Dam
GROUND PROFILE FOR SECTION R-26

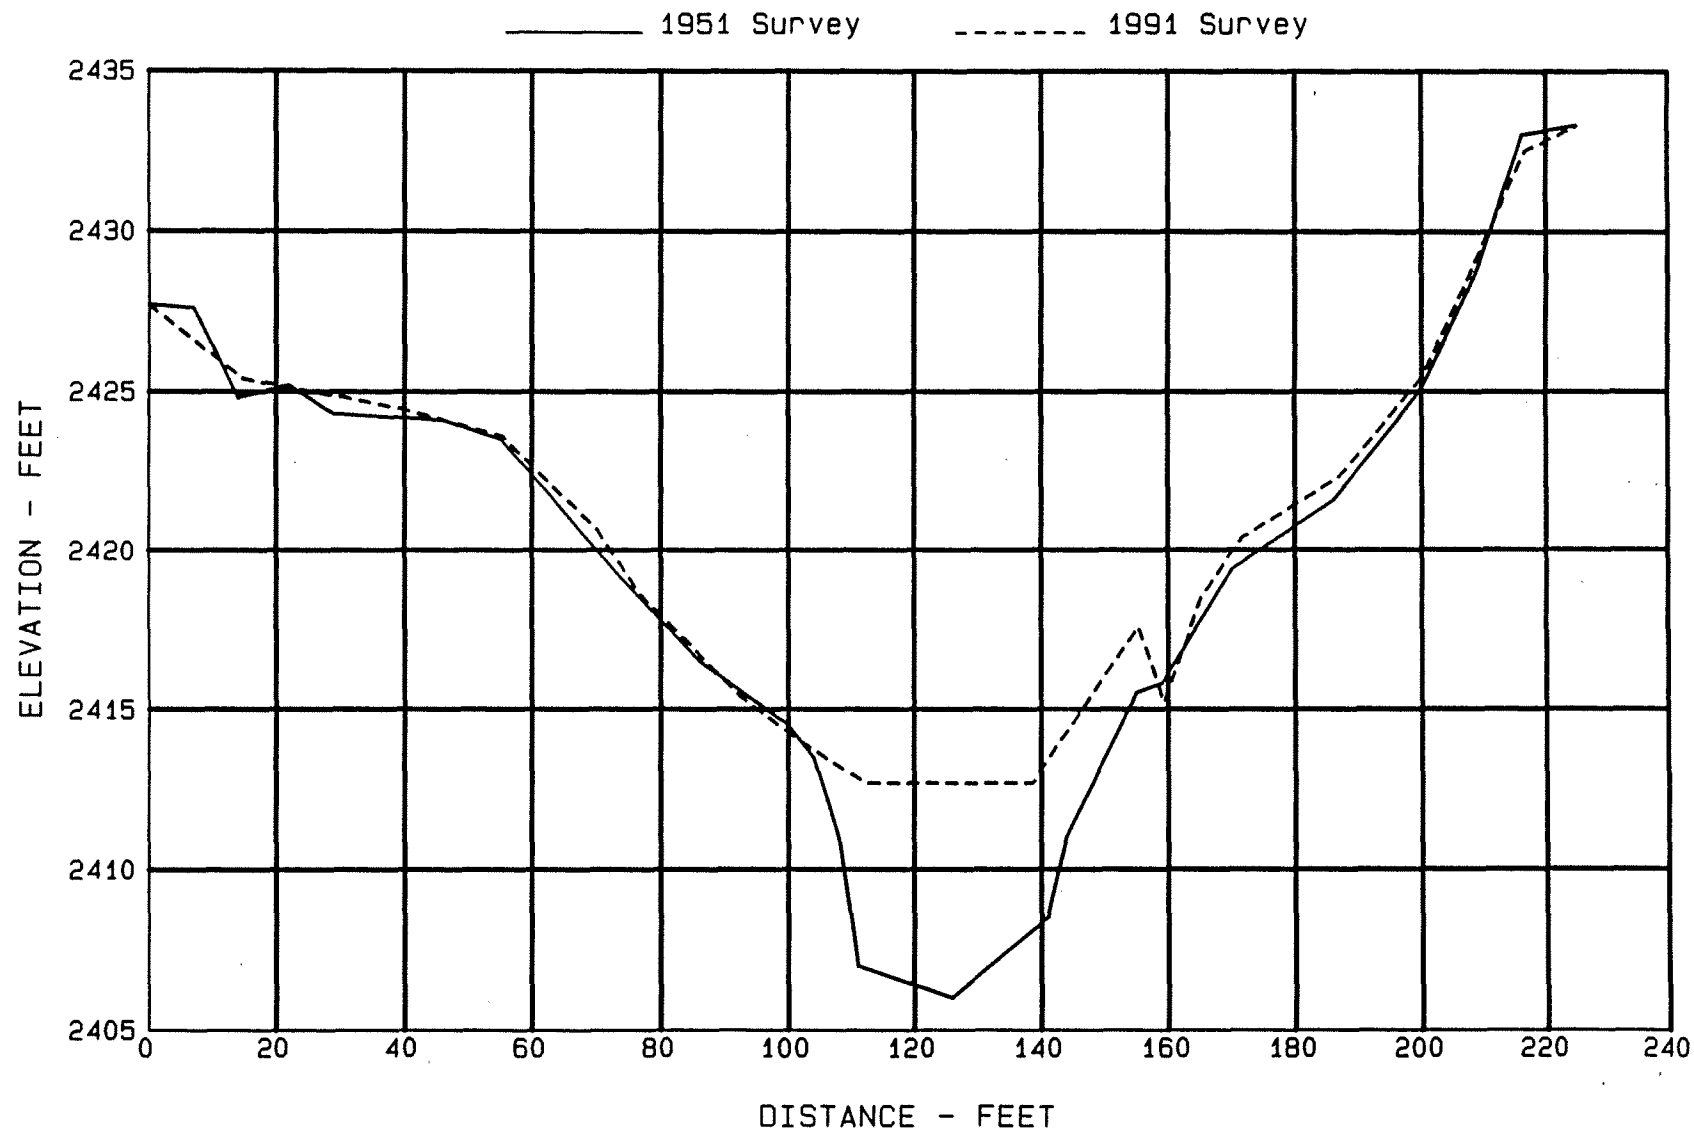


Figure 30. - Dickinson Dam ground profile for section R-26.

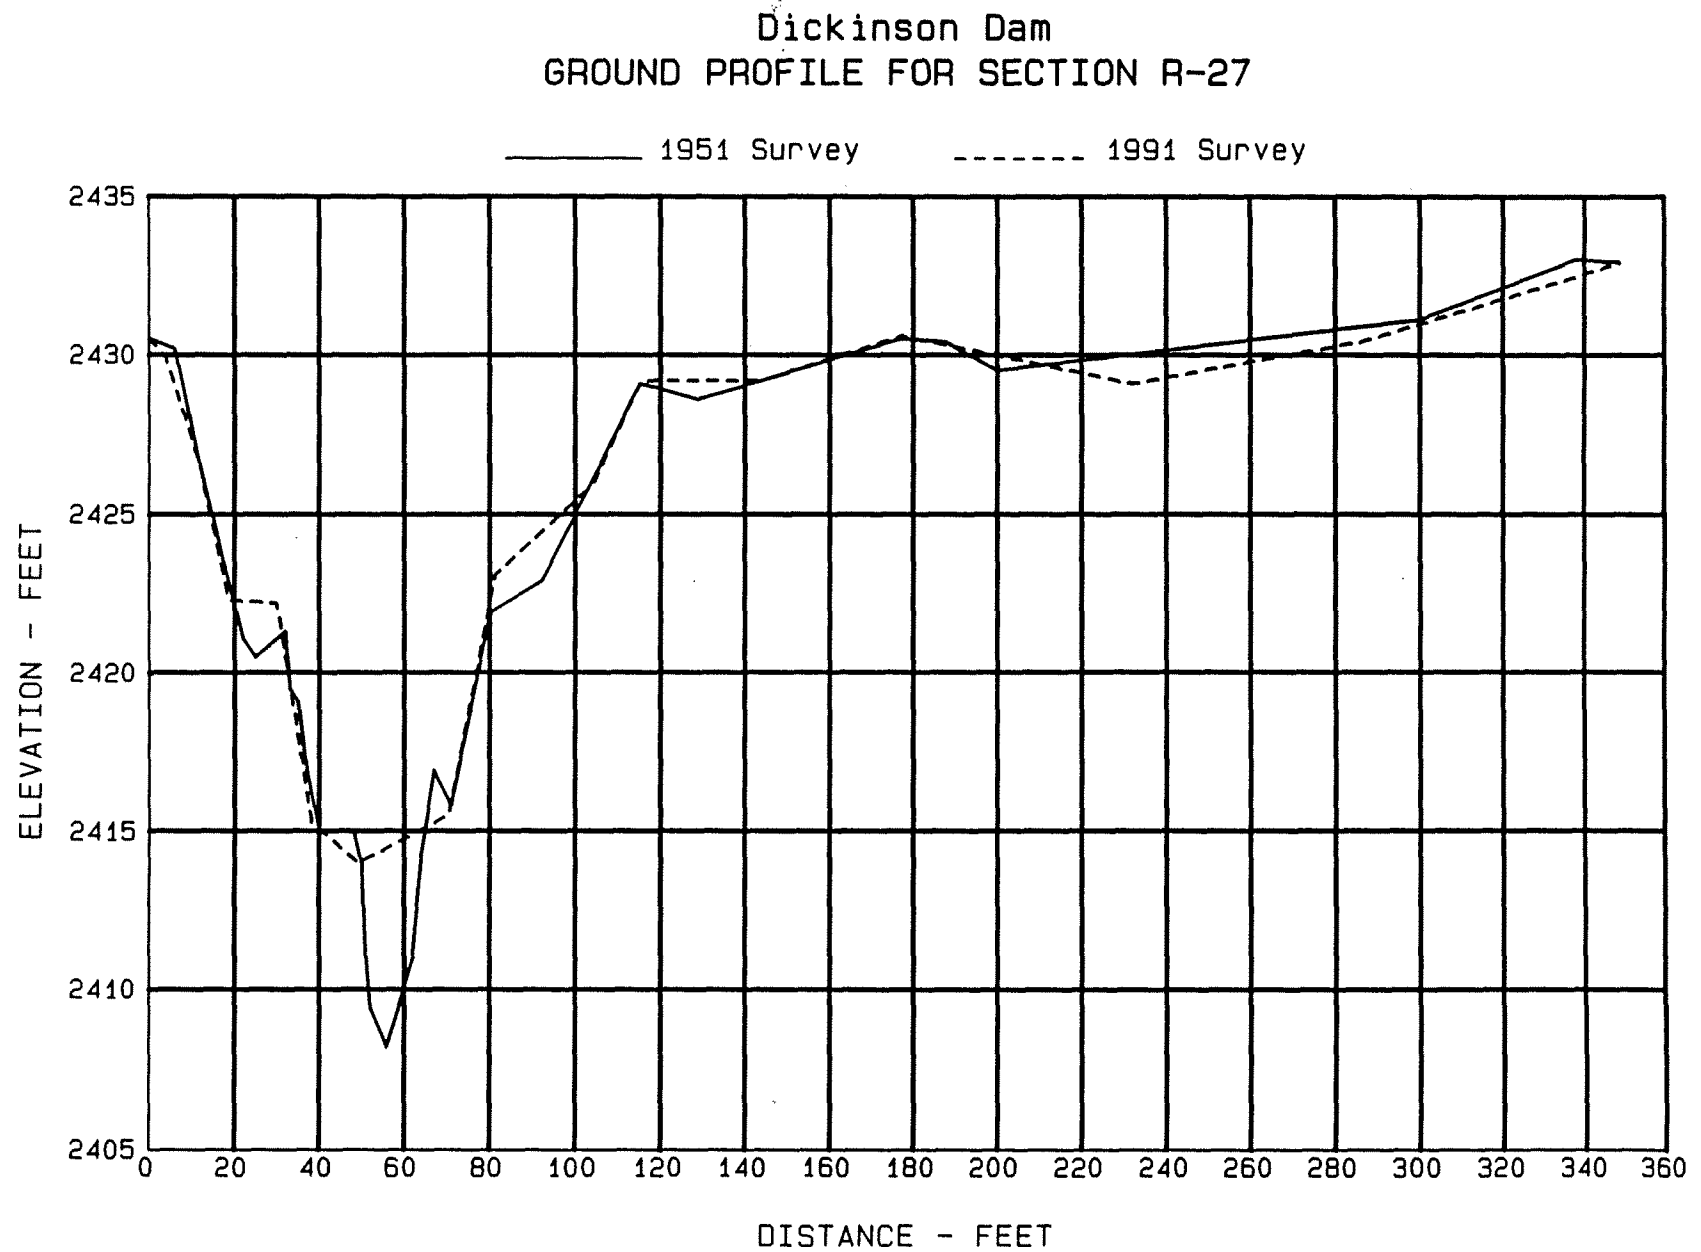


Figure 31. - Dickinson Dam ground profile for section R-27.

Dickinson Dam
GROUND PROFILE FOR SECTION R-28

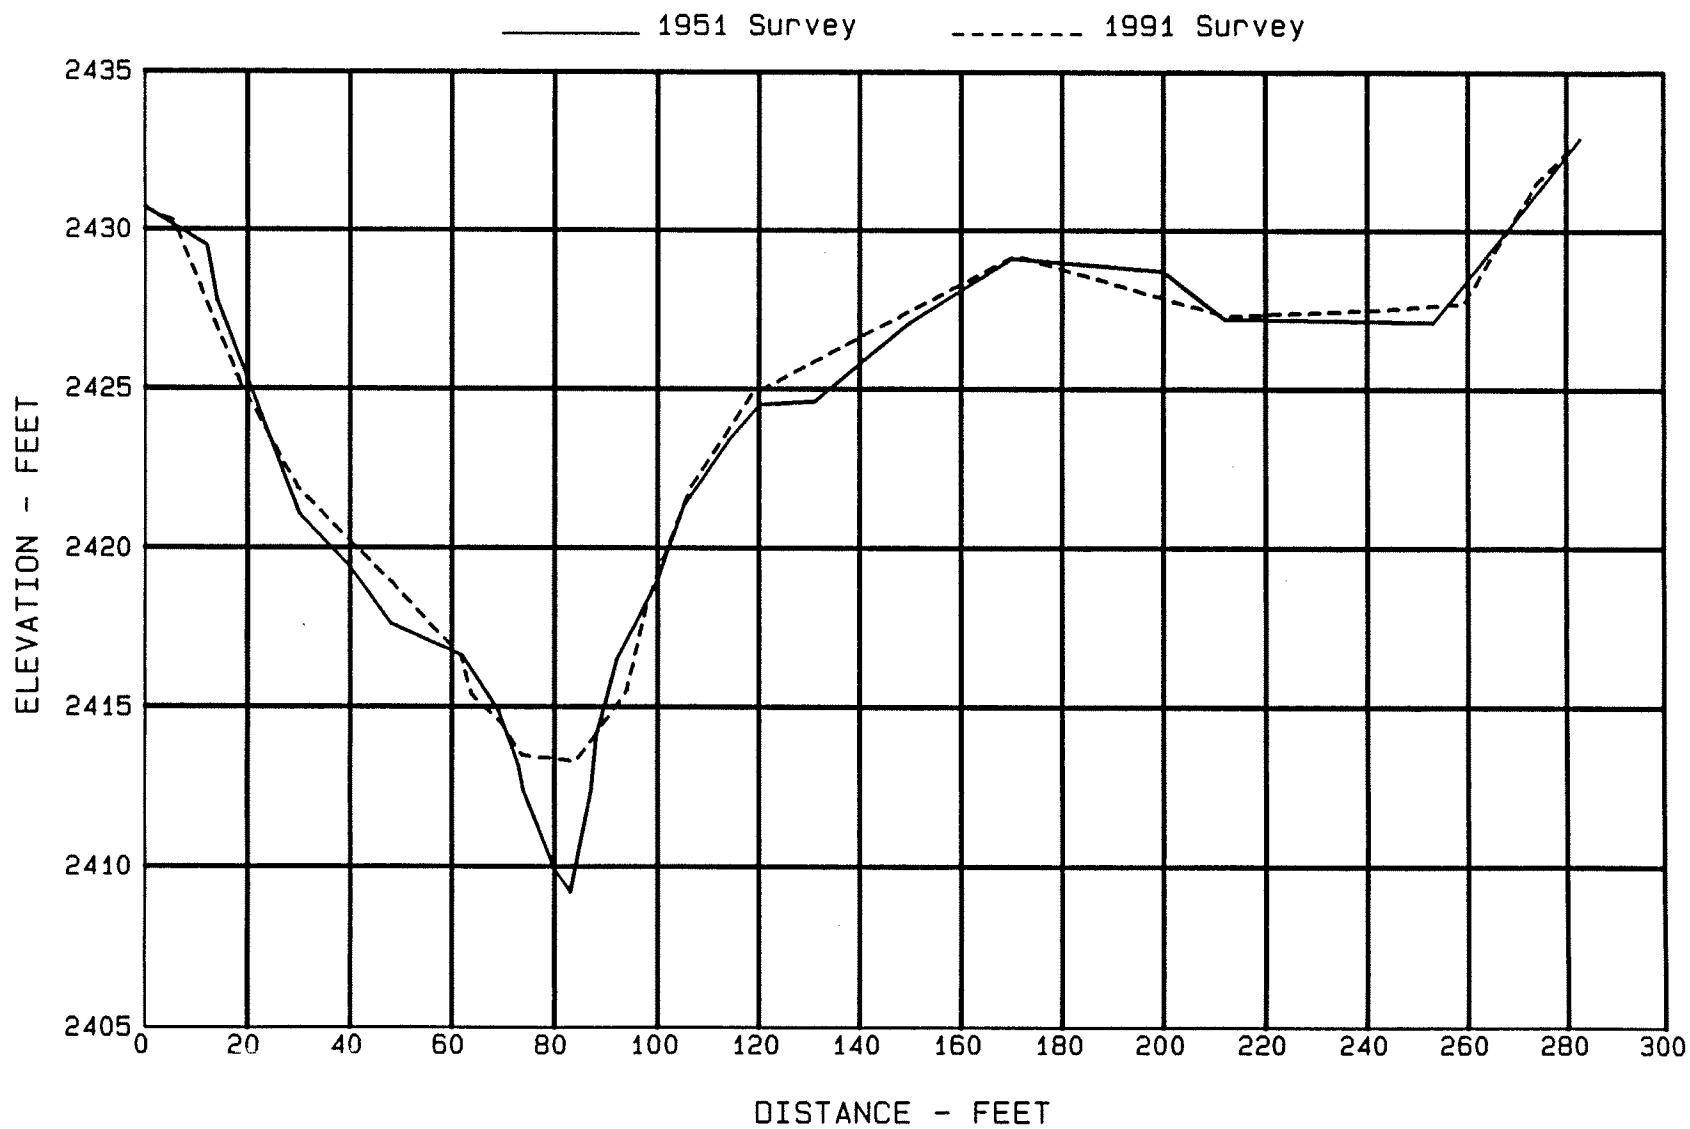


Figure 32. - Dickinson Dam ground profile for section R-28.

Dickinson Dam
GROUND PROFILE FOR SECTION R-29

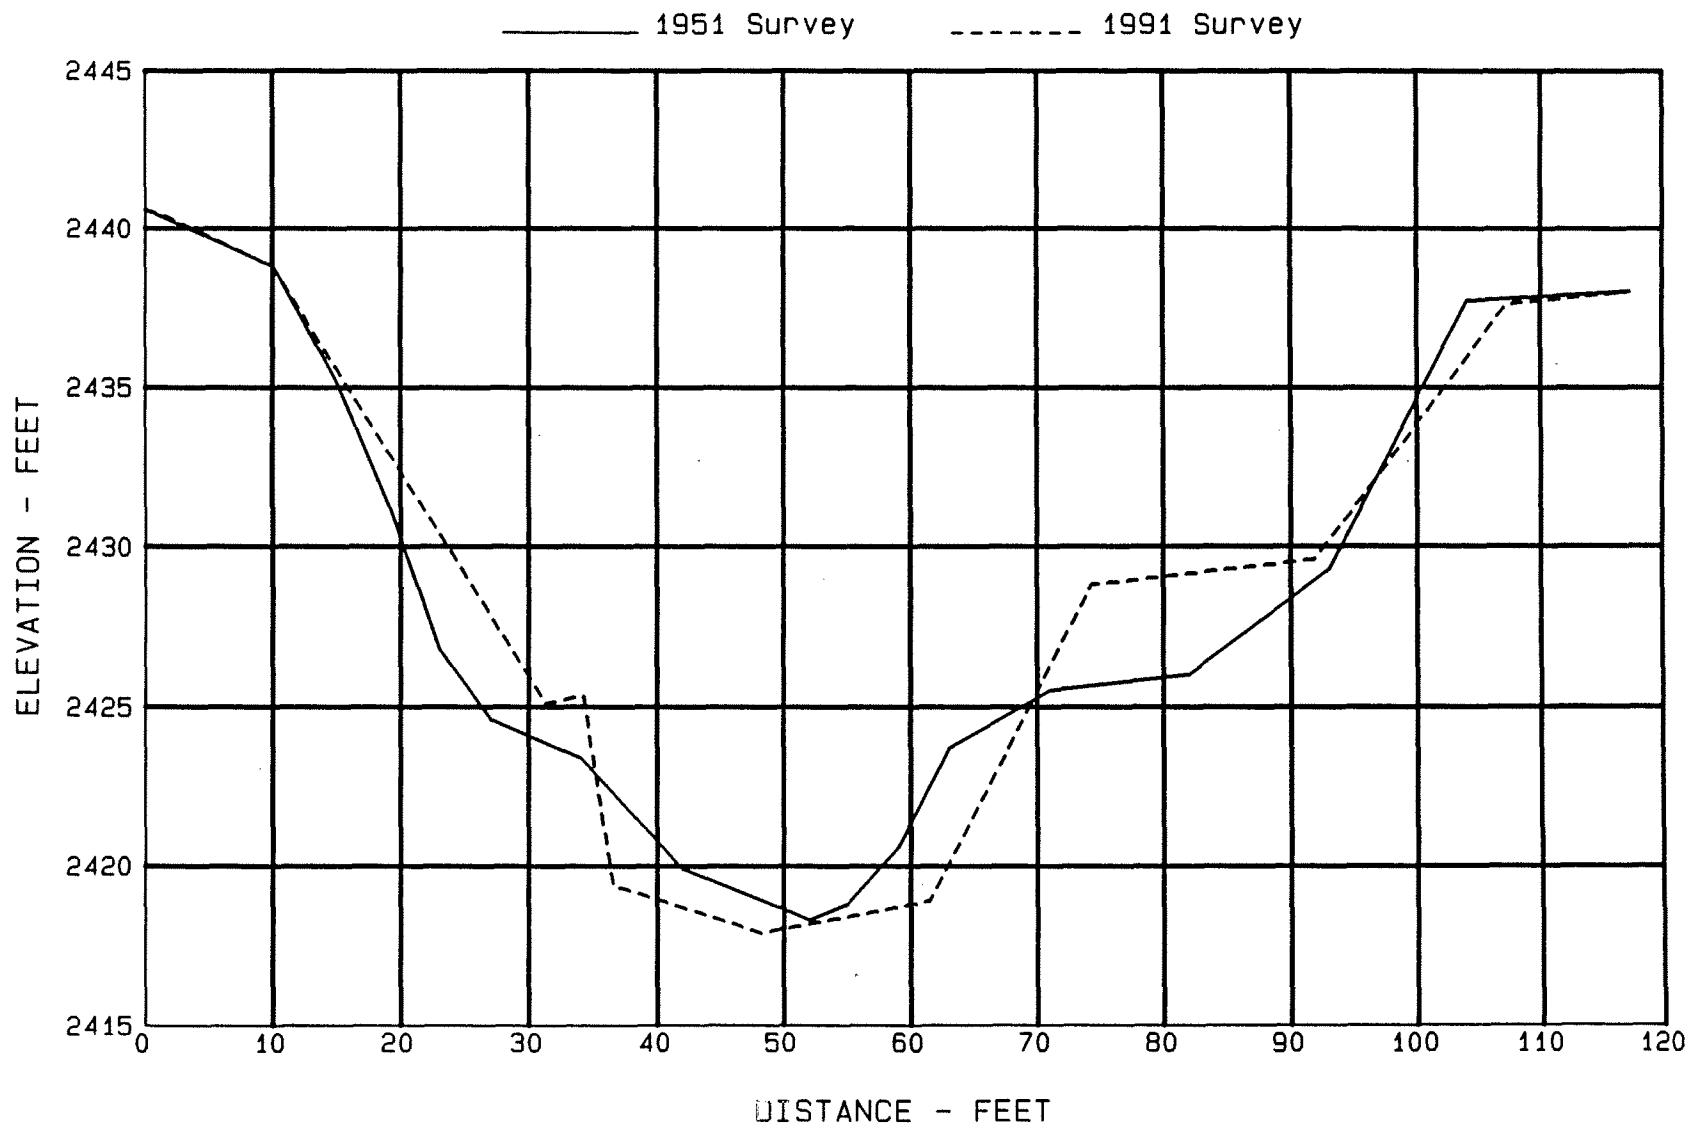


Figure 33. - Dickinson Dam ground profile for section R-29.

Dickinson Dam GROUND PROFILE FOR SECTION R-40

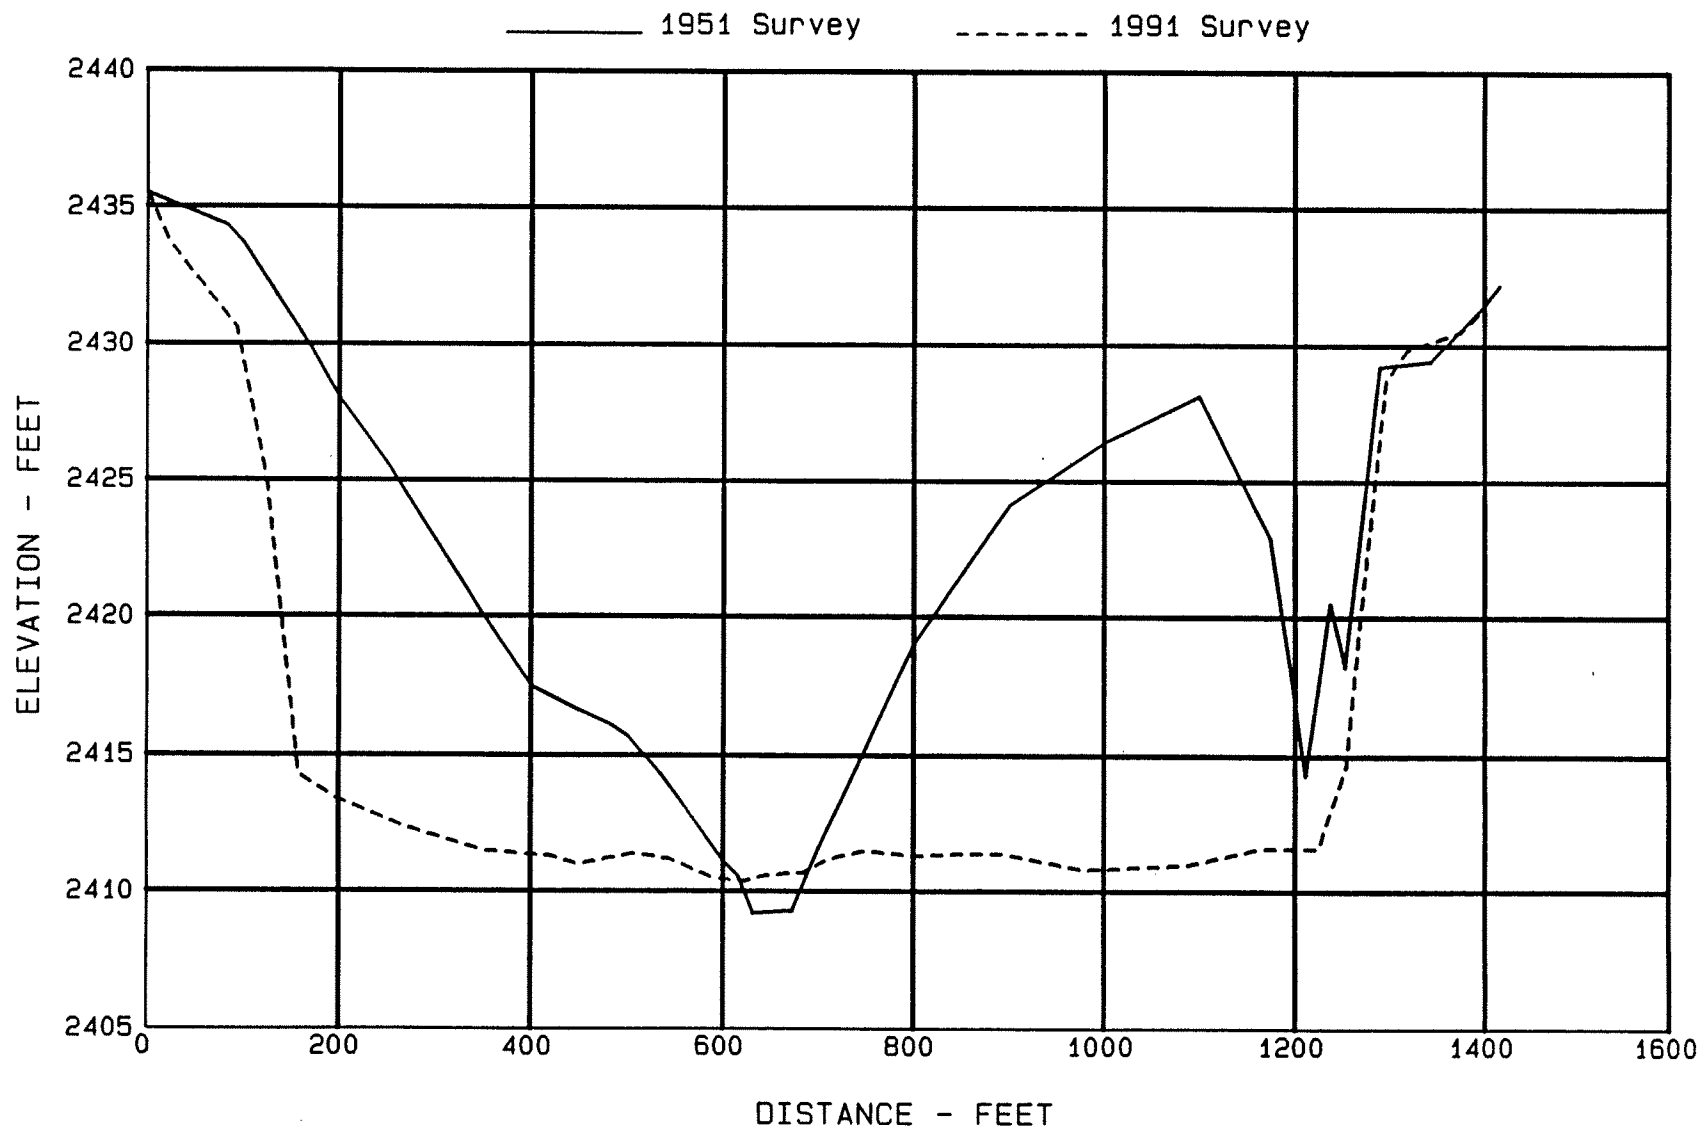


Figure 34. - Dickinson Dam ground profile for section R-40.

Dickinson Dam
GROUND PROFILE FOR SECTION R-50

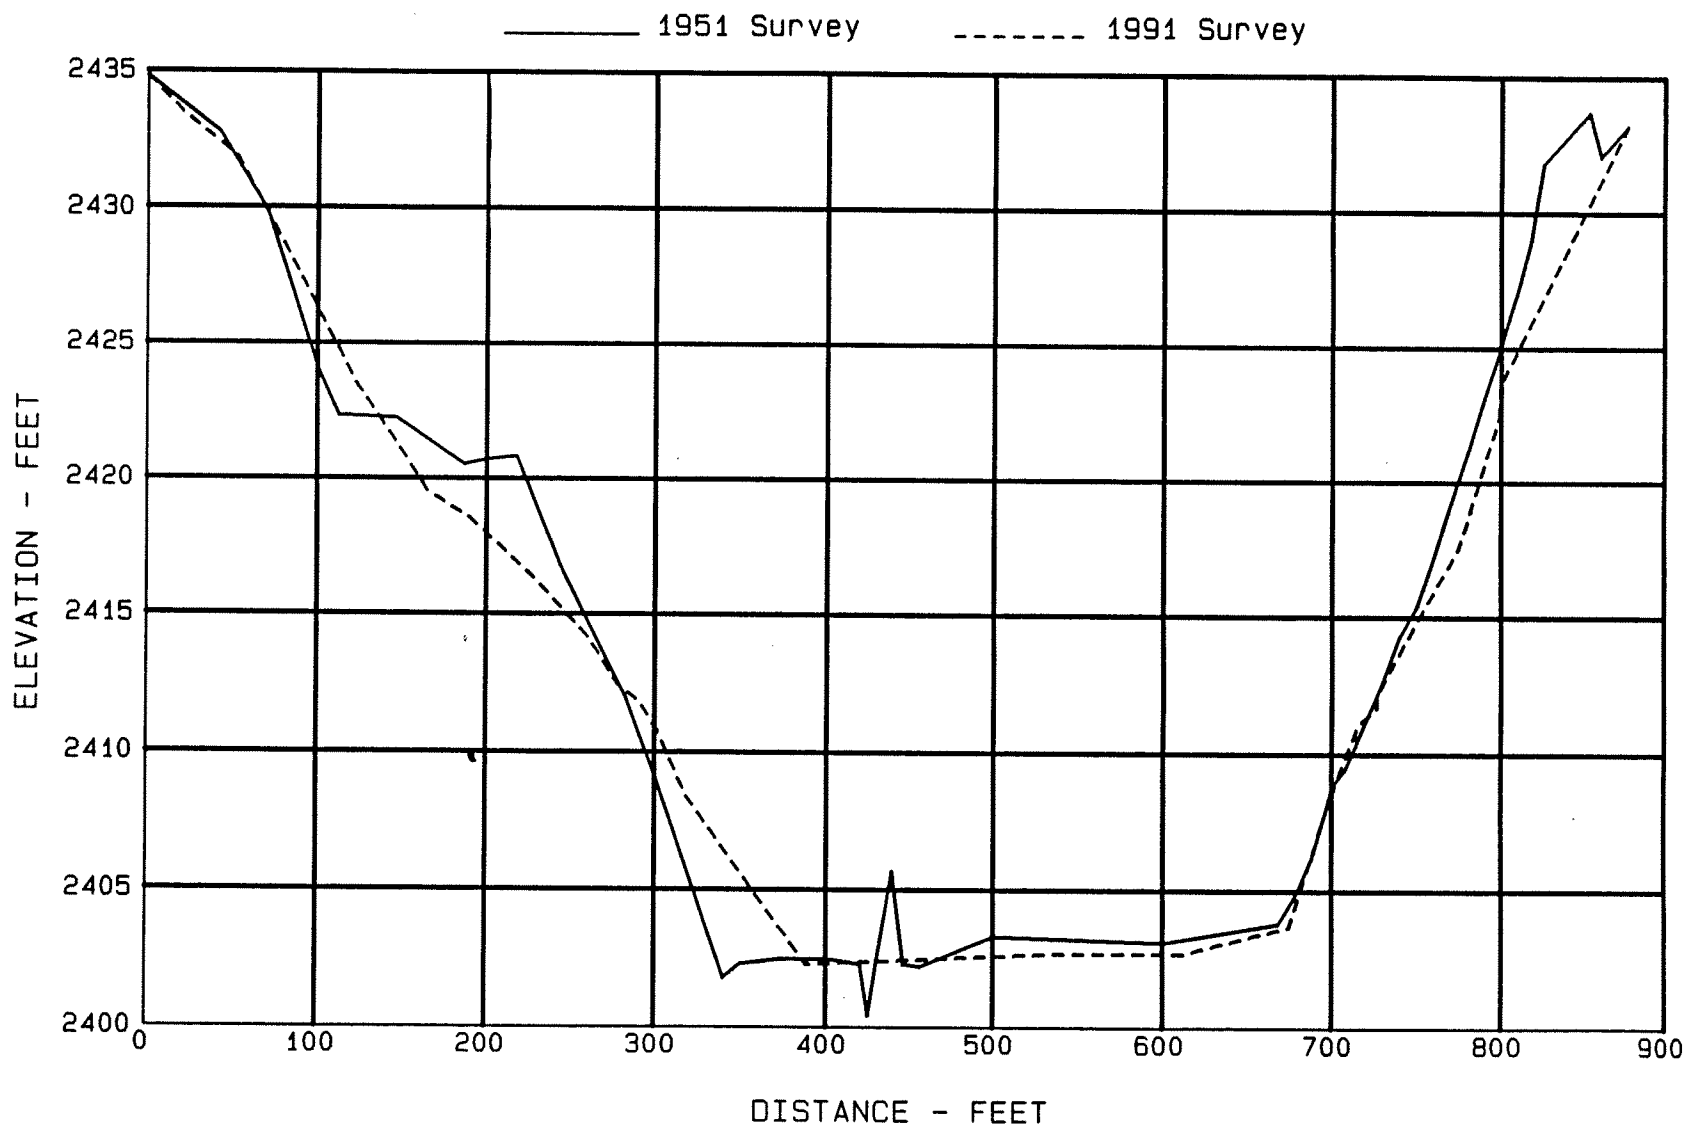


Figure 35. - Dickinson Dam ground profile for section R-50.

Dickinson Dam GROUND PROFILE FOR SECTION R-51

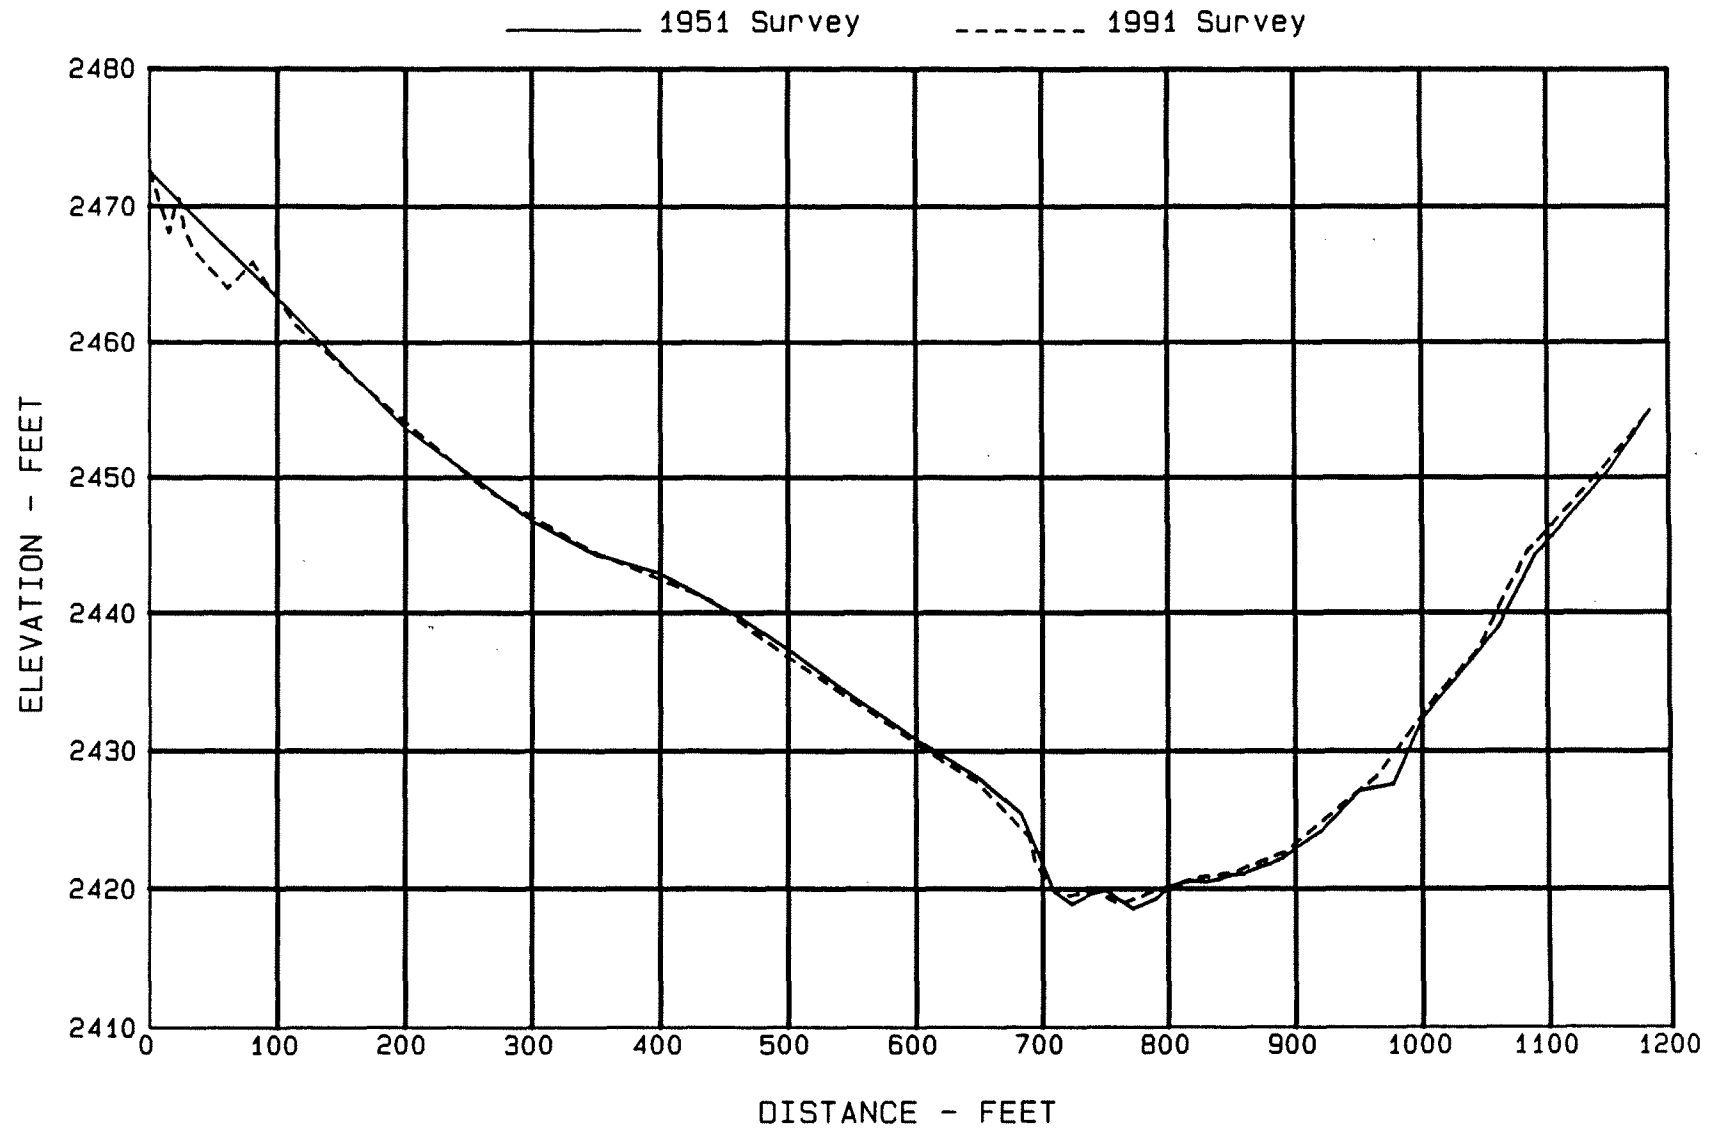


Figure 36. - Dickinson Dam ground profile for section R-51.

Dickinson Dam
GROUND PROFILE FOR SECTION R-60

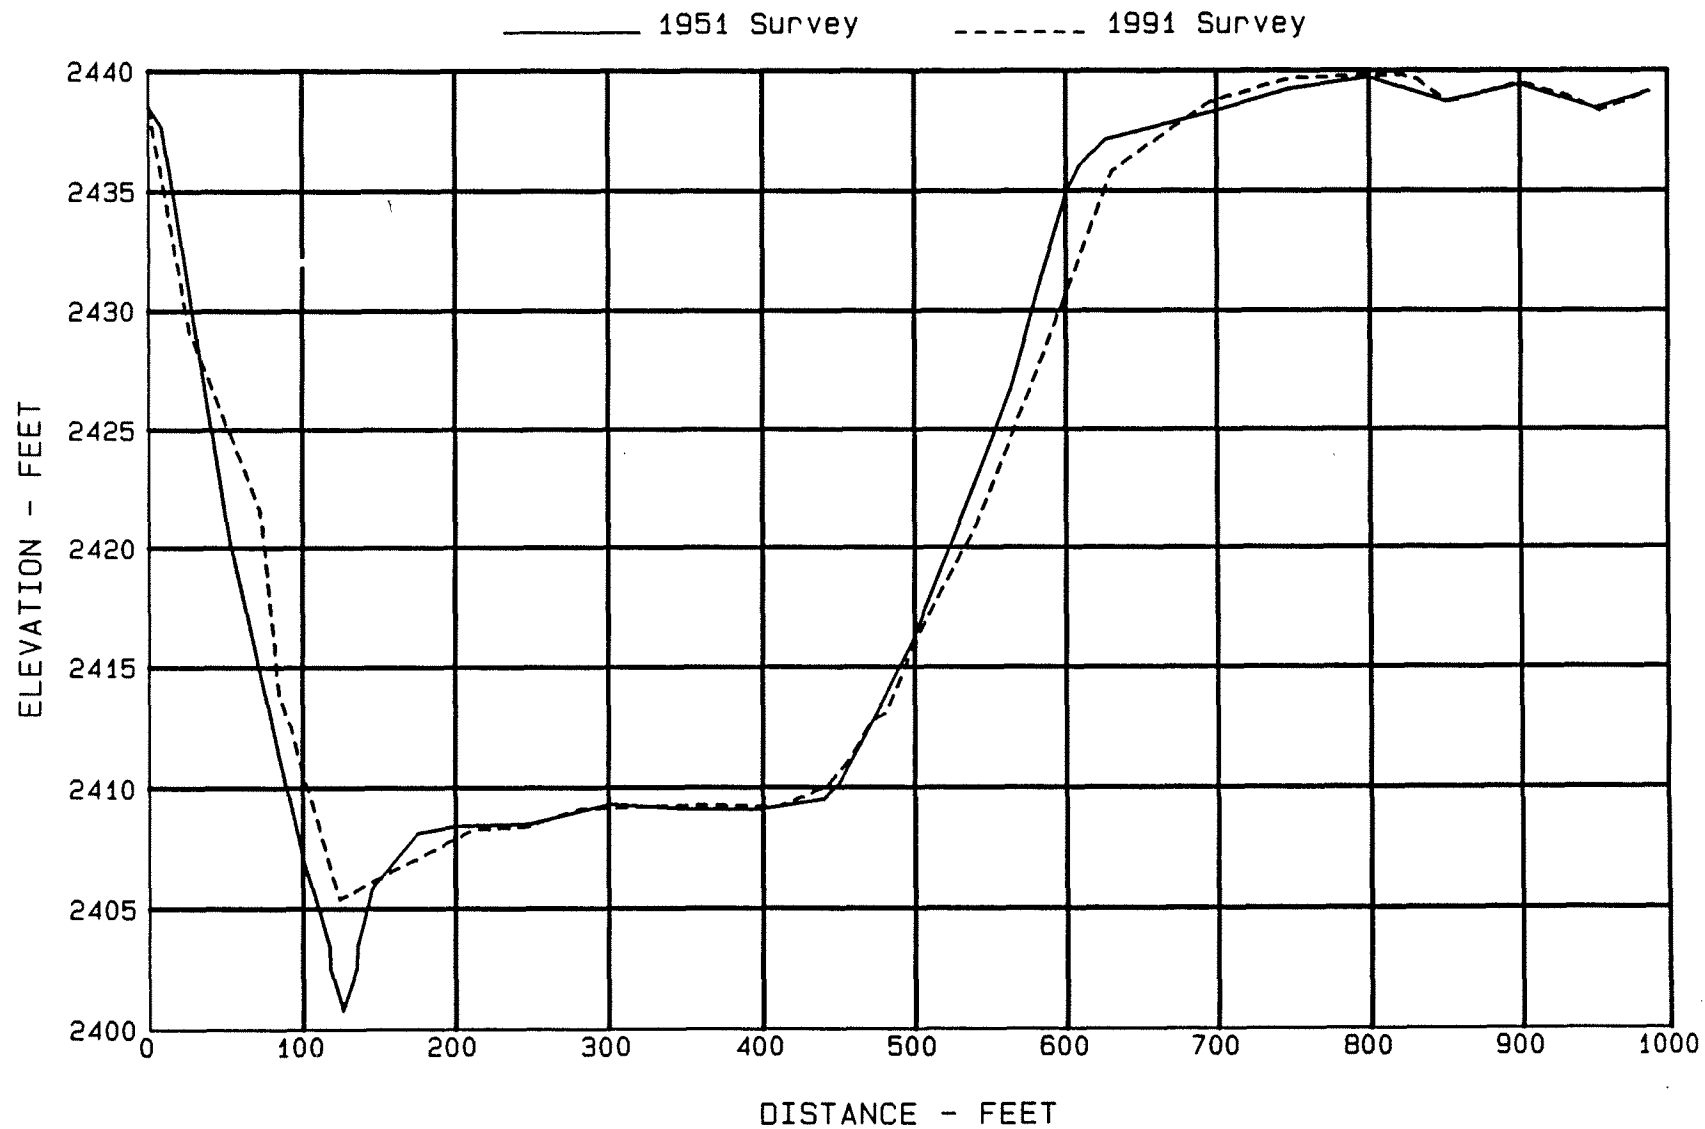


Figure 37. - Dickinson Dam ground profile for section R-60.

Dickinson Dam
GROUND PROFILE FOR SECTION R-61

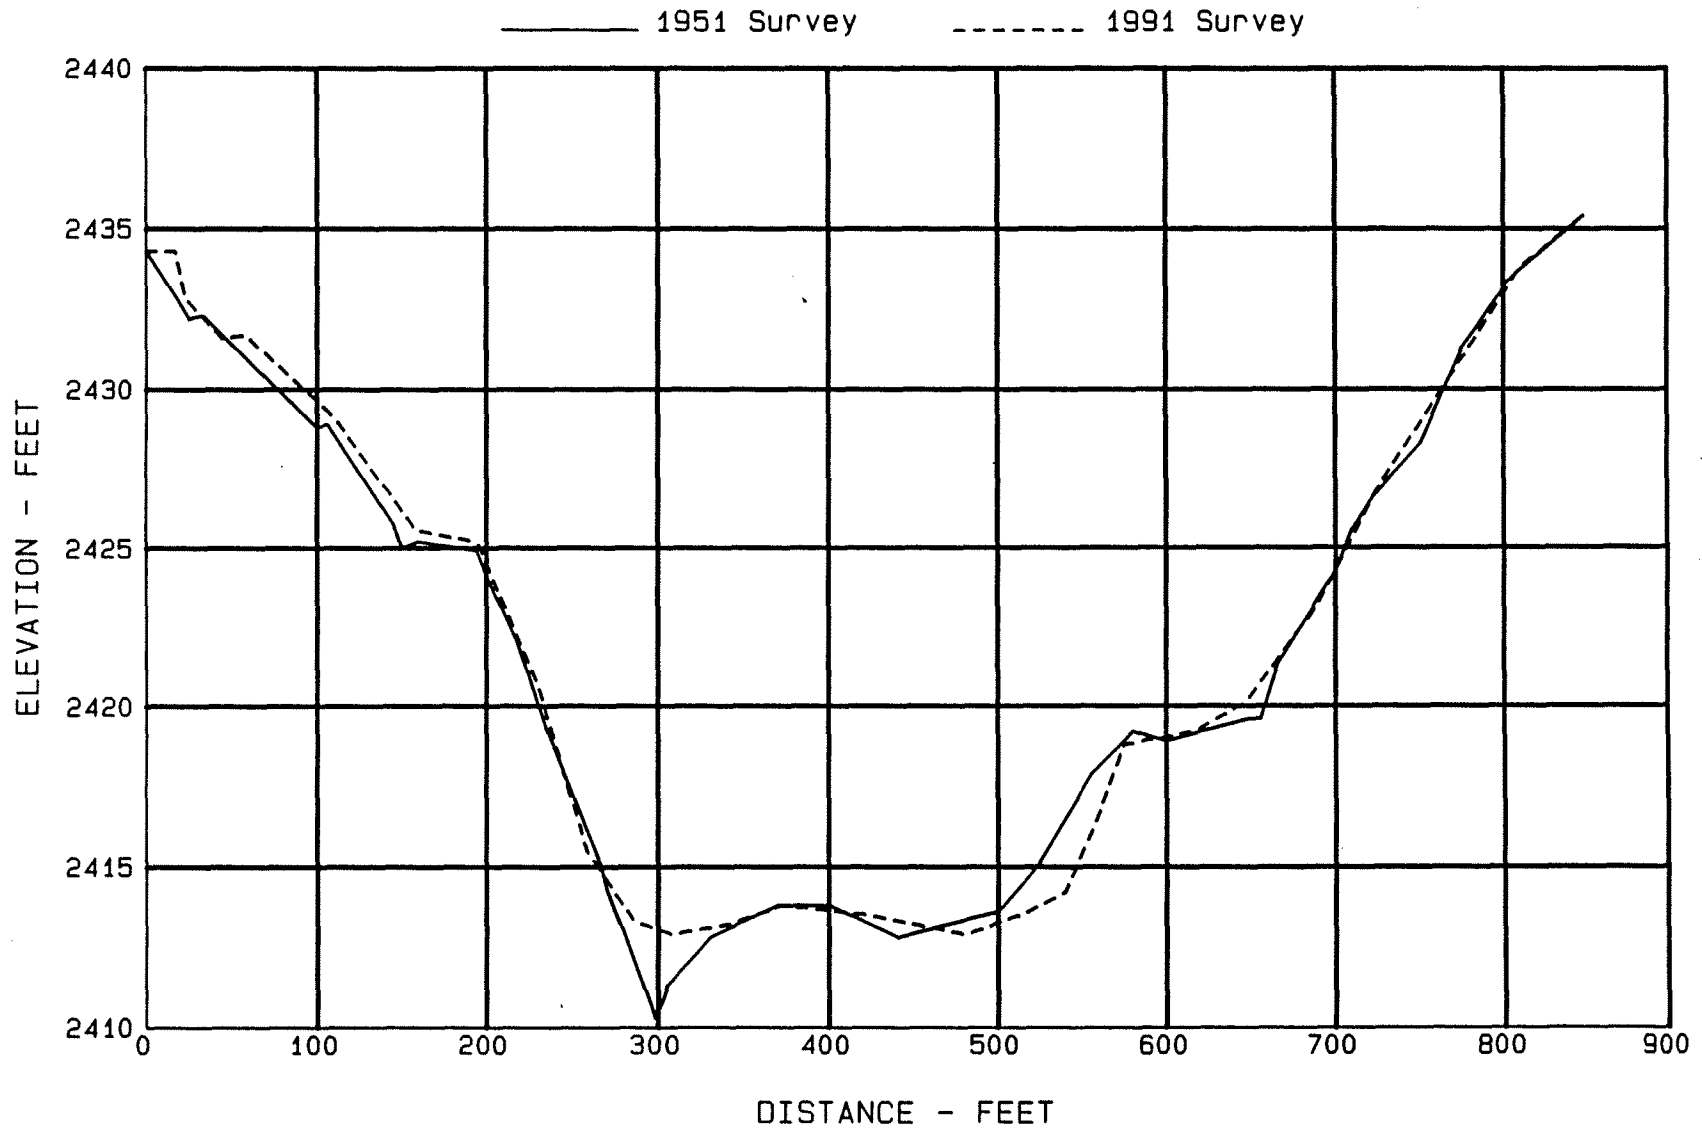


Figure 38. - Dickinson Dam ground profile for section R-61.

Dickinson Dam
GROUND PROFILE FOR SECTION R-62

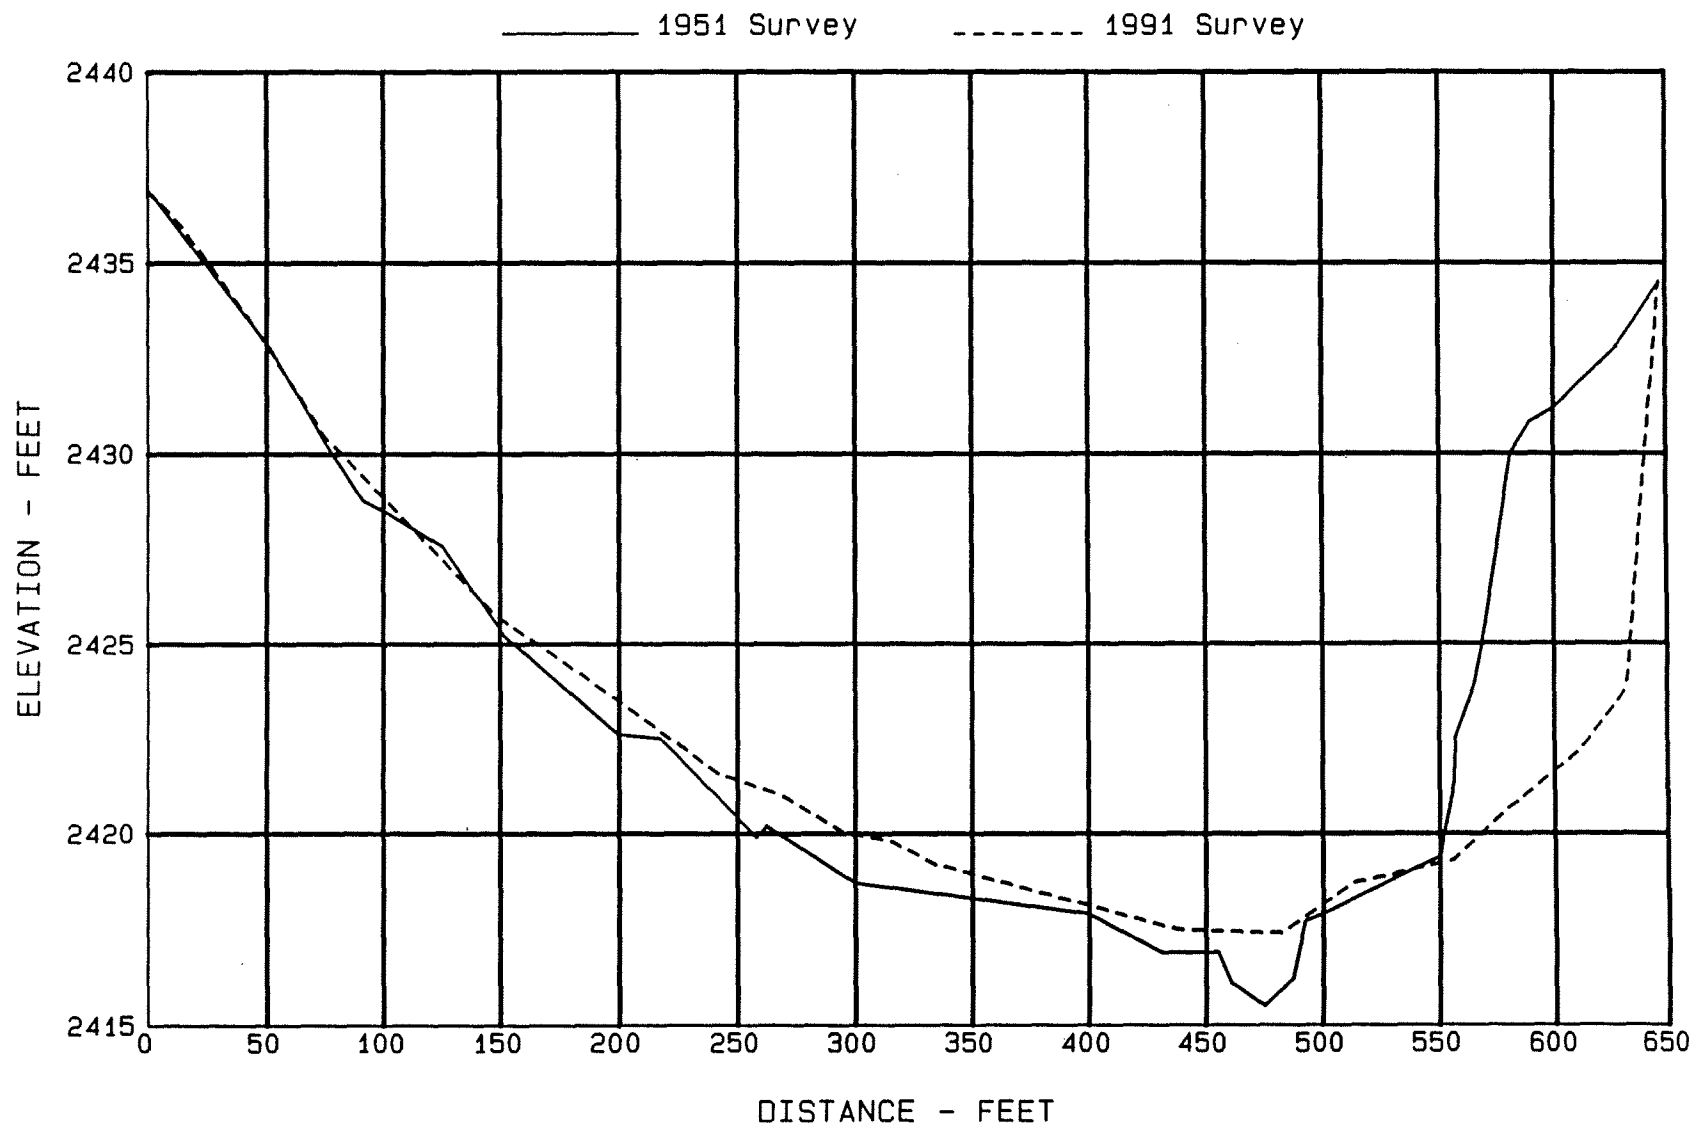


Figure 39. - Dickinson Dam ground profile for section R-62.

Dickinson Dam GROUND PROFILE FOR SECTION R-70

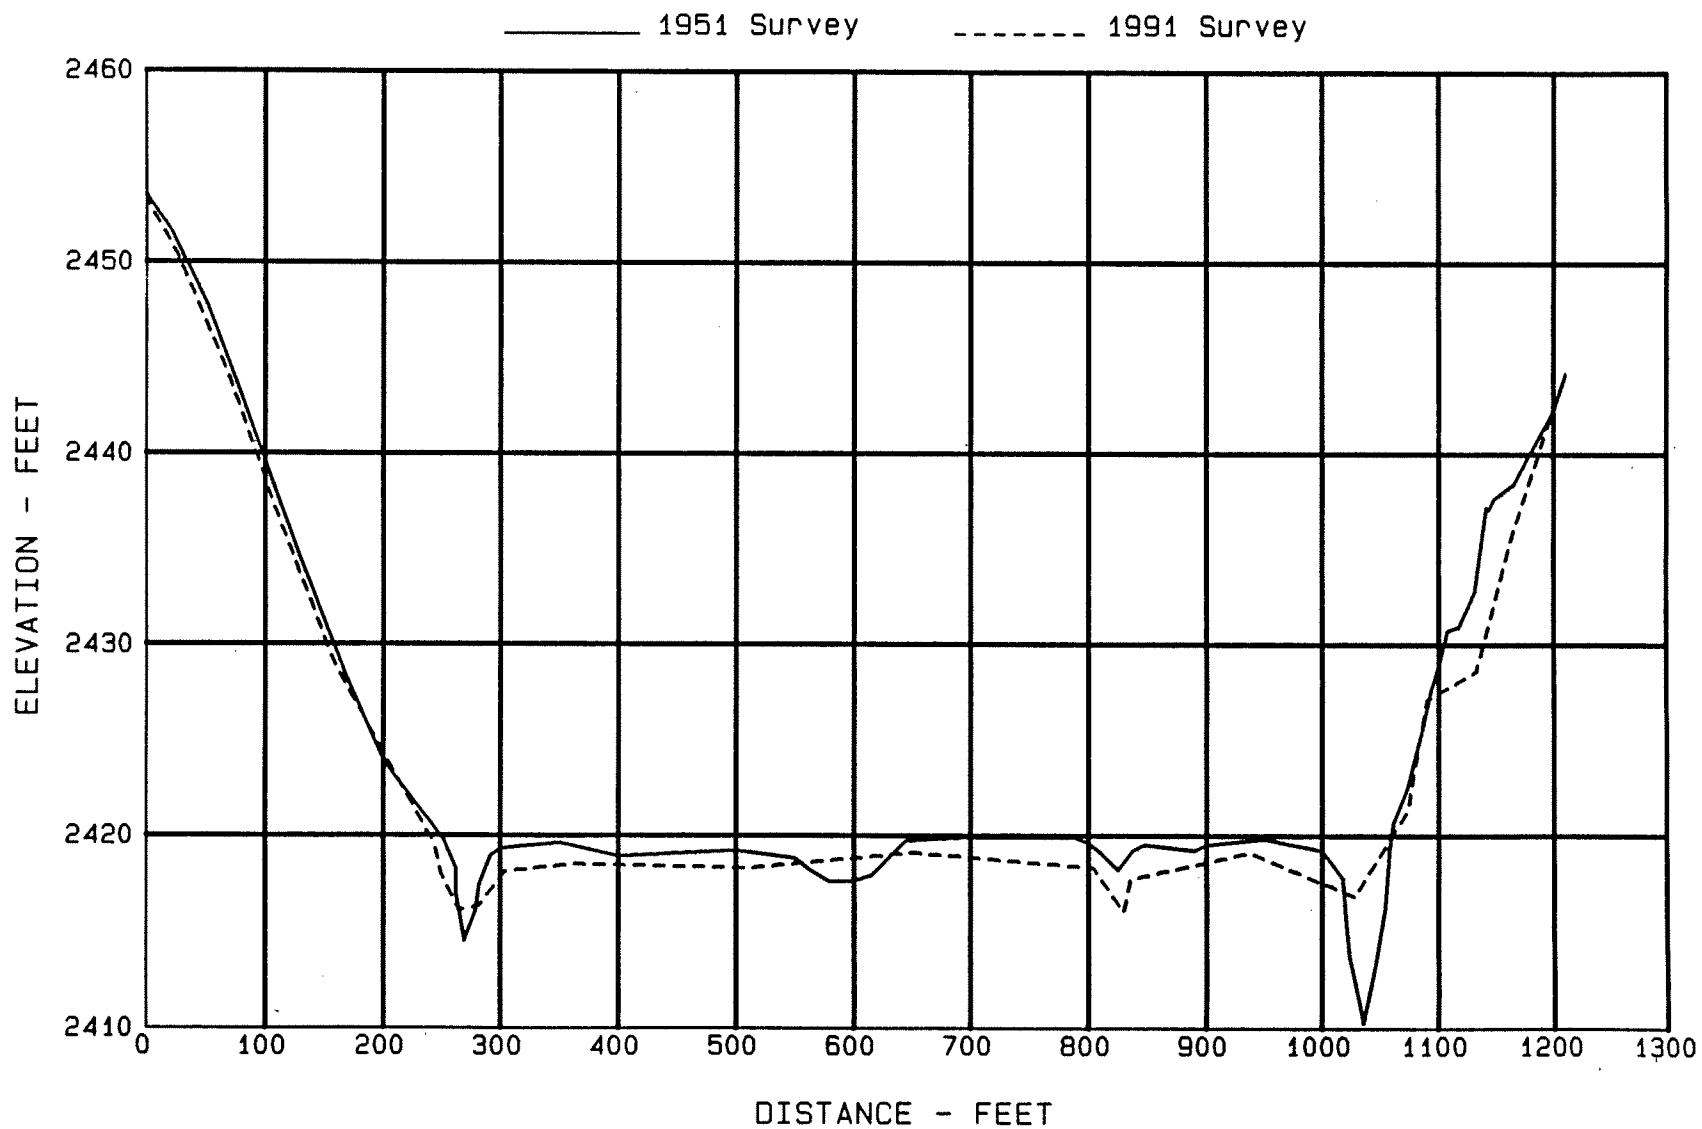


Figure 40. - Dickinson Dam ground profile for section R-70.

Dickinson Dam
GROUND PROFILE FOR SECTION R-71

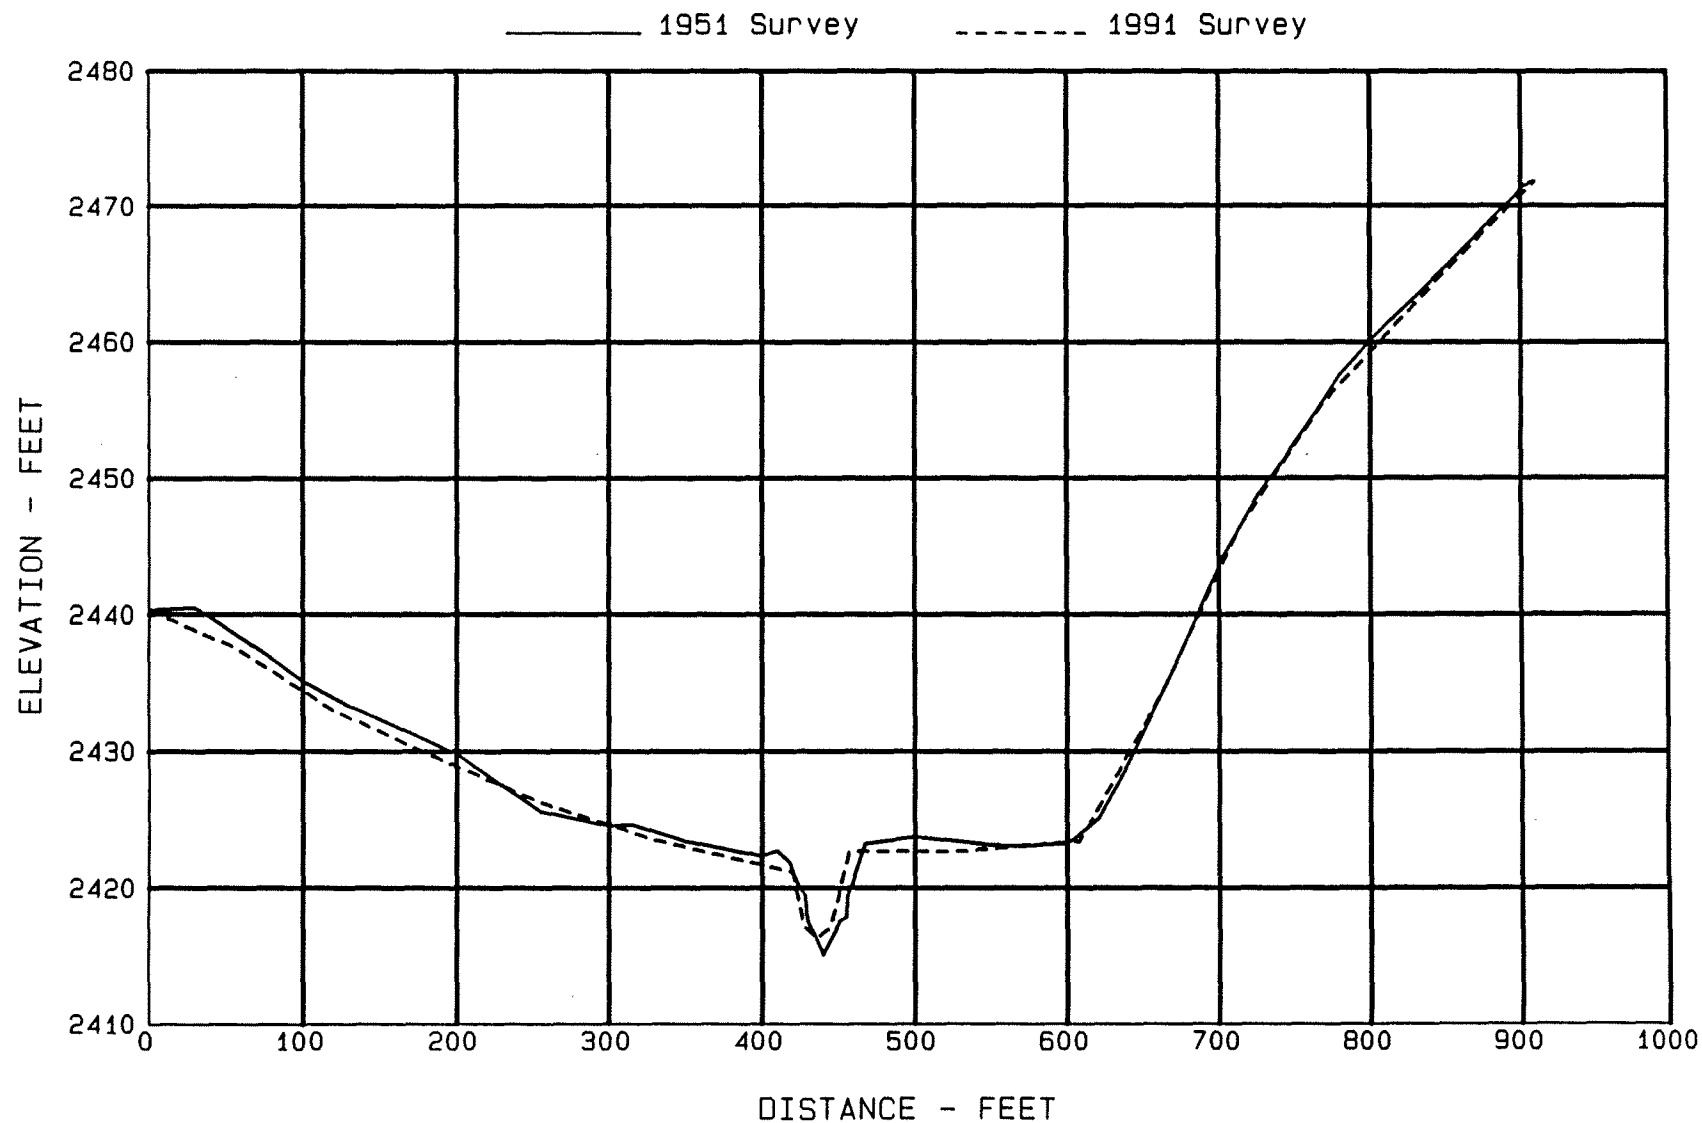


Figure 41. - Dickinson Dam ground profile for section R-71.

Dickinson Dam
GROUND PROFILE FOR SECTION R-80

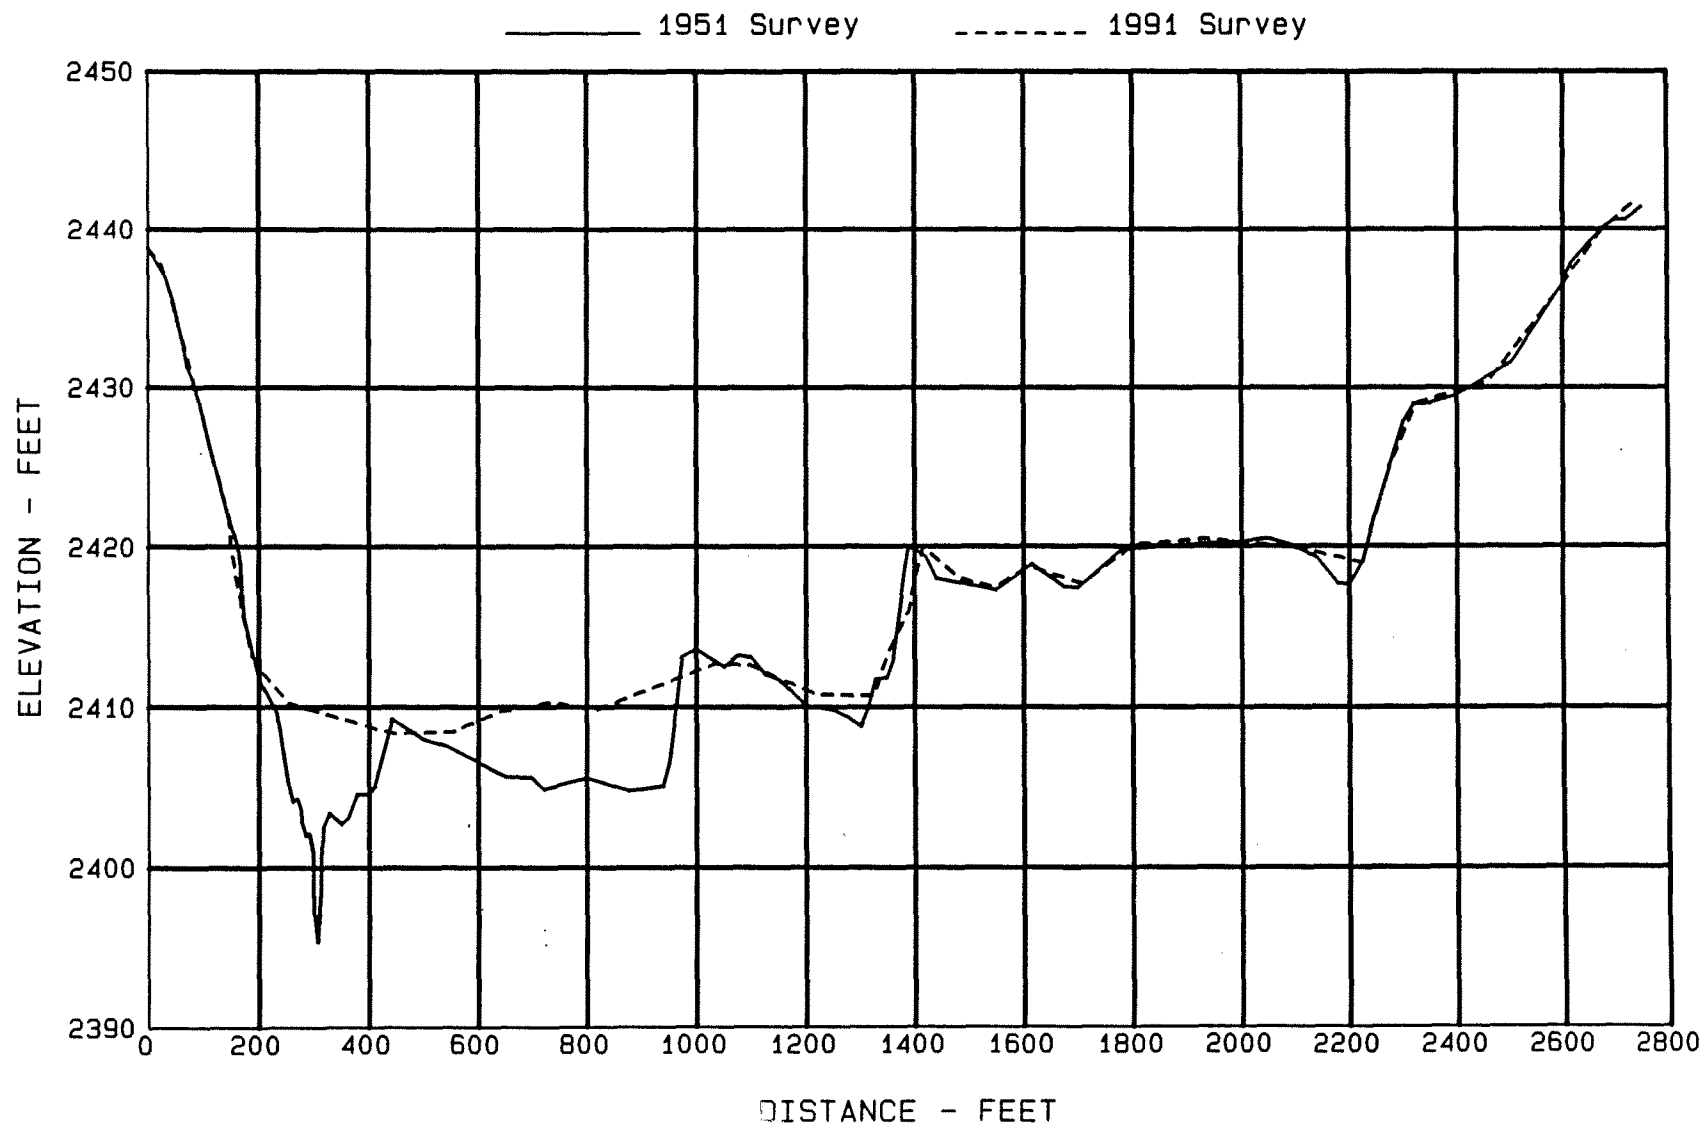


Figure 42. - Dickinson Dam ground profile for section R-80.

Dickinson Dam
GROUND PROFILE FOR SECTION R-81

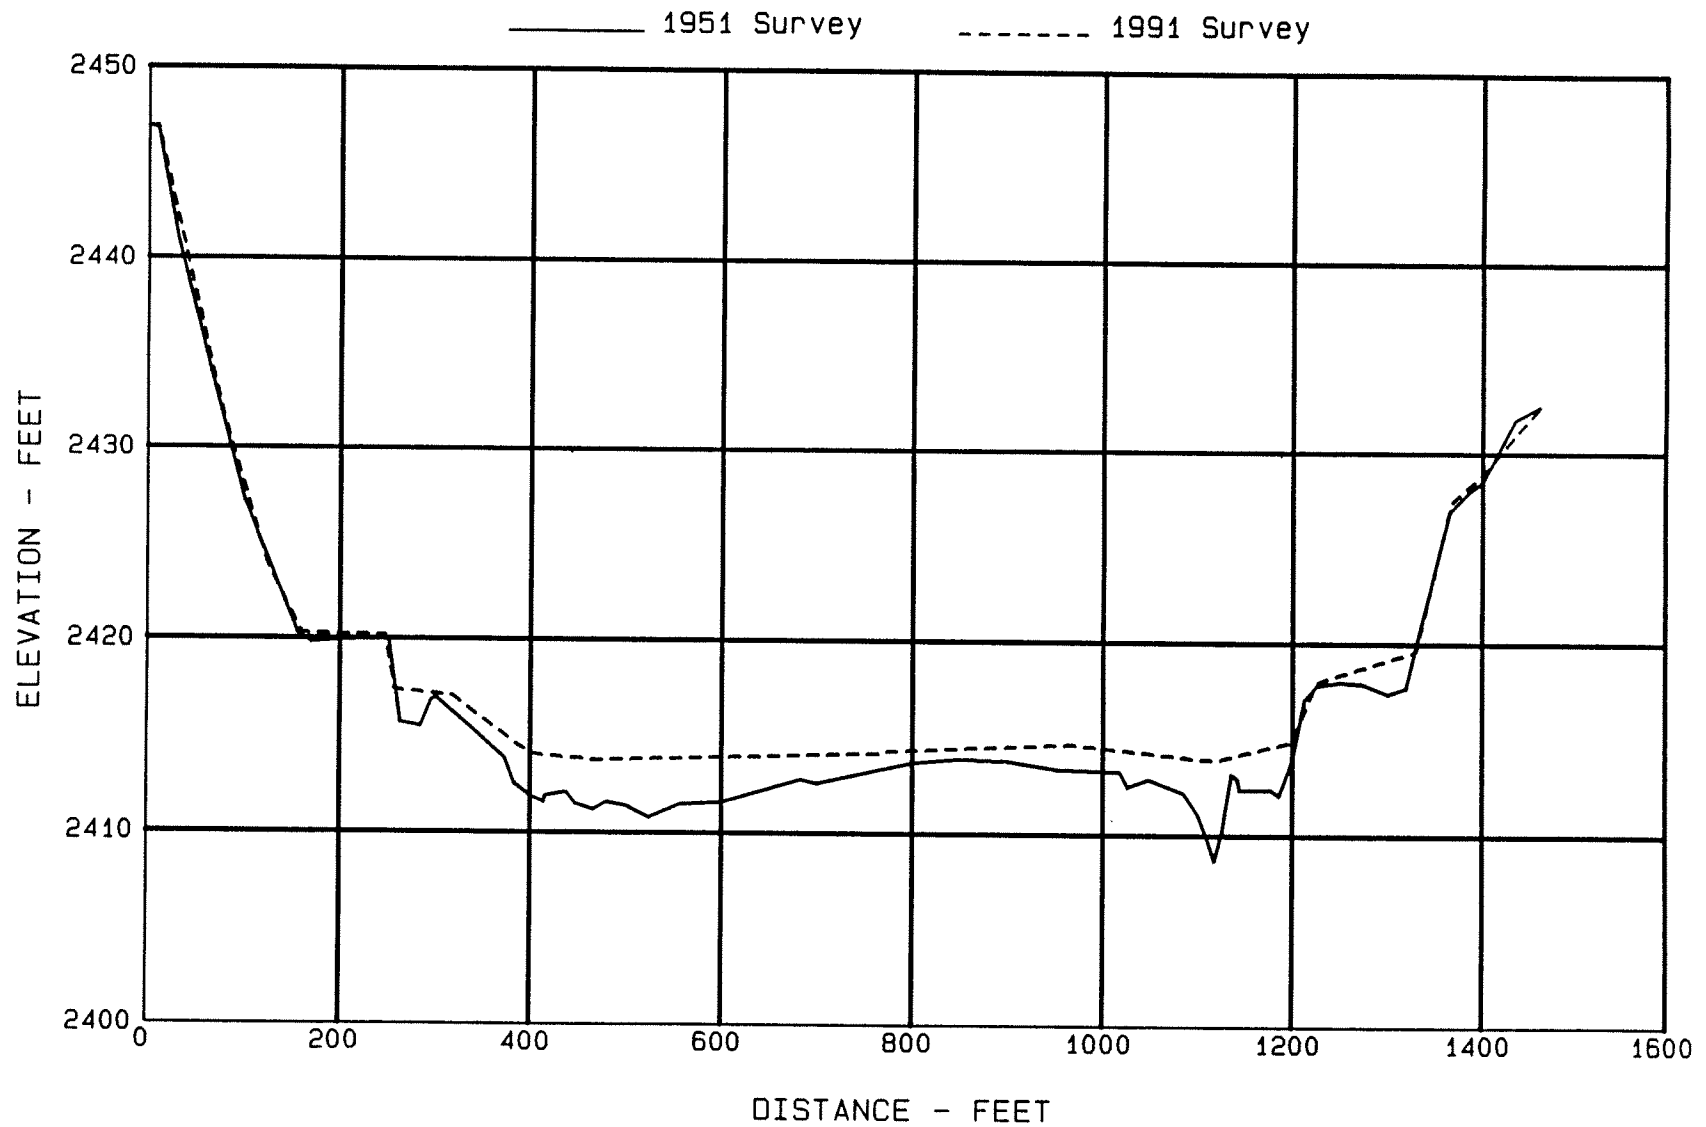


Figure 43. - Dickinson Dam ground profile for section R-81.

Dickinson Dam
GROUND PROFILE FOR SECTION R-82

———— 1951 Survey - - - - - 1991 Survey

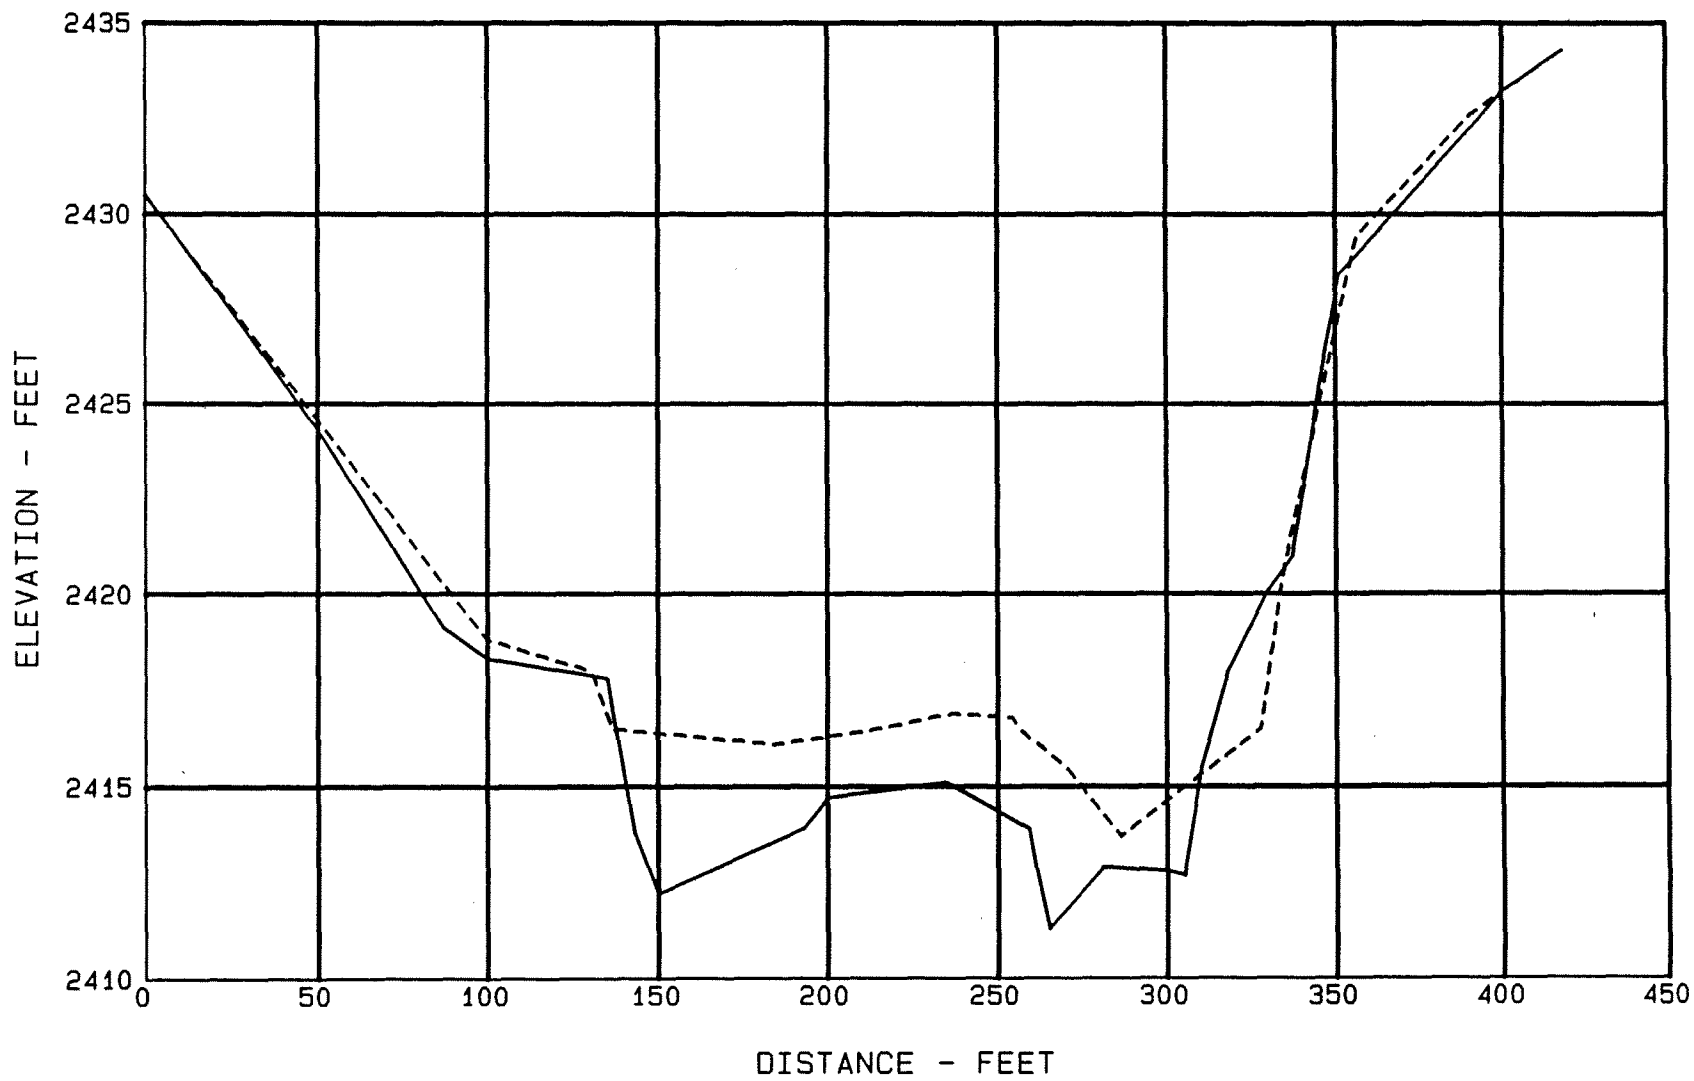


Figure 44. - Dickinson Dam ground profile for section R-82.

Dickinson Dam GROUND PROFILE FOR SECTION R-83

———— 1951 Survey - - - - - 1991 Survey

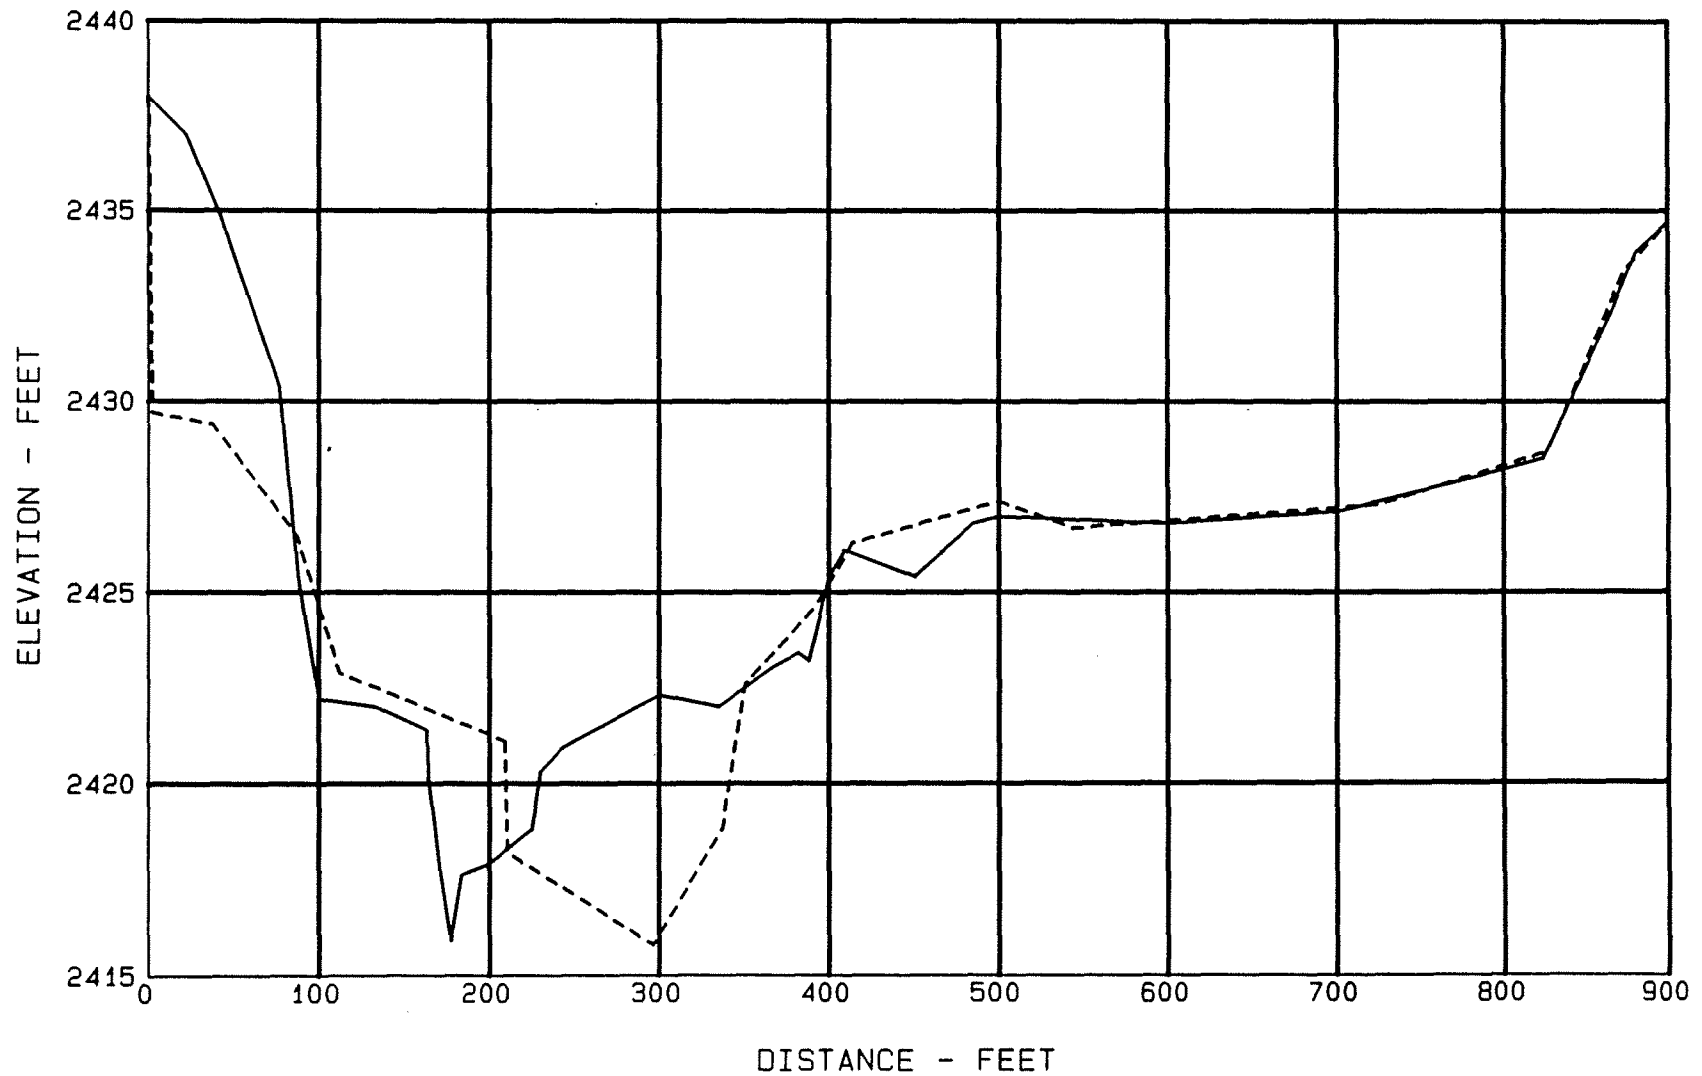


Figure 45. - Dickinson Dam ground profile for section R-83.

Mission

The mission of the Bureau of Reclamation is to manage, develop, and protect water and related resources in an environmentally and economically sound manner in the interest of the American Public.